

**WICKLOW COUNTY COUNCIL**

**PLANNING & DEVELOPMENT ACTS 2000 (As Amended)  
SECTION 5**

**Director of Services Order No:** 1220/2022

**Reference Number:** EX 41/2022

**Name of Applicant:** Oisin Gibson C/O Pol Gallagher ZAP Architecture

**Nature of Application:** Section 5 Referral as to whether or not – Lower ground floor bedrooms extended to add 16.4msq, - Changes to 3 windows on lower ground floor southern elevation, underground light well not visible from the road. – Extension of 3.2msq to ground floor over gap in front elevation. – Larger windows. – Rooflight & Velux windows over eastern side of dwelling. – Purposed retaining wall to side of dwelling. – Purposed bridge to front door, at Hillcrest Lower Kindlestown, Greystones, Co Wicklow is or is not exempted development.

**Location of Subject Site:** Hillcrest Lower Kindlestown, Greystones, Co Wicklow

**RECOMMENDATION:** Report from Lyndsey Blackmore AP

With respect – Lower ground floor bedrooms extended to add 16.4msq, - Changes to 3 windows on lower ground floor southern elevation, underground light well not visible from the road. – Extension of 3.2msq to ground floor over gap in front elevation. – Larger windows. – Rooflight & Velux windows over eastern side of dwelling. – Purposed retaining wall to side of dwelling. – Purposed bridge to front door, at Hillcrest Lower Kindlestown, Greystones, Co Wicklow to the query under Section 5 of the Planning & Development Act 2000 as to whether is or is not exempted development within the meaning of the Planning & Development Act 2000 (as amended)

**Having regard to:**

- The details submitted with this application 27<sup>th</sup> June 2022.
- Sections 2 & 3 of the Planning & Development Act 2000(as amended).
- Schedule 4(1)(h), of the Planning & Development Act 2000(as amended).
- Article 6(1) Planning & Development Regulations, 2001(as amended).
- Article 9 (1); Planning & Development Regulations, 2001(as amended).
- Part 1 (Classes 1, 5 & 6) of Schedule 2 Planning & Development Regulations, 2001(as amended):



**Main reasons with respect to section to Section 5 Declaration:**

1. The changes consisting of the
  - Lower ground floor bedrooms extended to add 16.4msq
  - Changes to 3 windows on lower ground floor southern elevation, underground light well not visible from the road.
  - Extension of 3.2msq to ground floor over gap in front elevation.
  - Larger windows
  - Rooflight & velux windows over eastern side of dwelling.

Would not materially affect the external appearance of the structure so as to render the appearance inconsistent with the character of the structure or of neighbouring structures. The development would therefore come within the scope of section 4(1)(h) of the Planning & Development Act 2000 (as amended) and the extension would not exceed 40msq in area & would come under Part 1 Classes 1, of Schedule 2 Planning & Development Regulations, 2001(as amended).

2. The changes consisting of
  - Proposed retaining wall to side of dwelling
  - Proposed bridge to front door.

Would not materially alter the external appearance of the building so as to render the appearance inconsistent with the character of the structure. The development would not come within the scope of section 4(1)(h) of the Planning & Development Act 2000(as amended) and would not, given the height of the retaining wall and the differences in ground levels, fall under the conditions and Limitations of Part 1 (Classes 5 & 6) of Schedule 2 Planning & Development Regulations, 2001 (as amended).

The Planning Authority considers that Lower ground floor bedrooms extended to add 16.4msq, - Changes to 3 windows on lower ground floor southern elevation, underground light well not visible from the road. - Extension of 3.2msq to ground floor over gap in front elevation. - Larger windows. - Rooflight & Velux windows over eastern side of dwelling at Hillcrest Lower Kindlestown, Greystones, Co Wicklow **is development but is exempted development**

The Planning Authority considers that Purposed retaining wall to side of dwelling. Purposed bridge to front door, at Hillcrest Lower Kindlestown, Greystones, Co Wicklow **is development & is NOT exempted development**



**ORDER:**

---

That a declaration to issue stating:

That Lower ground floor bedrooms extended to add 16.4msq, - Changes to 3 windows on lower ground floor southern elevation, underground light well not visible from the road. - Extension of 3.2msq to ground floor over gap in front elevation. - Larger windows. - Rooflight & Velux windows over eastern side of dwelling is development but is exempted development within the meaning of the Planning & Development Acts 2000 (as amended).

That Purposed retaining wall to side of dwelling & Purposed bridge to front door is development & is NOT exempted development within the meaning of the Planning & Development Acts 2000 (as amended).

Signed: 

Director of Services

Planning Development & Environment

Dated 22<sup>nd</sup> day of July 2022



# Comhairle Contae Chill Mhantáin Wicklow County Council

## Forbairt Pleanála agus Comhshaol Planning Development and Environment

Áras An Chontae / County Buildings  
Cill Mhantáin / Wicklow  
Guthán / Tel: (0404) 20148  
Faics / Fax: (0404) 69462  
Rphost / Email: [plandev@wicklowcoco](mailto:plandev@wicklowcoco)  
Suíomh / Website: [www.wicklow.ie](http://www.wicklow.ie)

Oisin Gibson  
C/O Pol Gallagher ZAP Architecture  
369 High Street  
London  
E15 4QZ

22<sup>nd</sup> July 2022

RE: Declaration in accordance with Section 5  
of the Planning & Development Acts 2000 (As Amended)

I enclose herewith Declaration in accordance with Article 5 (2) (A) of the  
Planning & Development Act 2000 in respect of the following:

Exemption Ref. No: EX 41/2022

Applicant: Oisin Gibson C/O Pol Gallagher ZAP Architecture

Nature of Application: Lower ground floor bedrooms extended to add  
16.4msq, - Changes to 3 windows on lower ground  
floor southern elevation, underground light well not  
visible from the road. - Extension of 3.2msq to  
ground floor over gap in front elevation. - Larger  
windows. - Rooflight & Velux windows over eastern  
side of dwelling. - Purposed retaining wall to side of  
dwelling. - Purposed bridge to front door, at Hillcrest  
Lower Kindlestown, Greystones, Co Wicklow

Location: Hillcrest Lower Kindlestown, Greystones, Co Wicklow

Where a Declaration is used under this Section any person issued with a  
Declaration under subsection (2) (a) may, on payment to An Bord Pleanála of  
such fee as may be prescribed, refer a declaration for review by the Board within  
four weeks of the date of the issuing of the declaration by the Local Authority.

Is mise, le meas,

**ADMINISTRATIVE OFFICER  
PLANNING DEVELOPMENT & ENVIRONMENT.**

This document is available in alternative formats on request*

Ba chóir gach comhfhreagras a sheoladh chuig an Stiúrthóir Seirbhísí, Forbairt Pleanála agus Comhshaol.  
All correspondence should be addressed to the Director of Services, Planning Development & Environment.







# Comhairle Contae Chill Mhantáin Wicklow County Council

**Forbairt Pleanála agus Comhshaol  
Planning Development and Environment**

Áras An Chontae / County Buildings  
Cill Mhantáin / Wicklow  
Guthán / Tel: (0404) 20148  
Faics / Fax: (0404) 69462  
Rphost / Email: [plandev@wicklowcoco](mailto:plandev@wicklowcoco)  
Suíomh / Website: [www.wicklow.ie](http://www.wicklow.ie)

## DECLARATION IN ACCORDANCE WITH ARTICLE 5 (2) (A) OF THE PLANNING & DEVELOPMENT ACT 2000 AS AMENDED

**Applicant: Oisin Gibson C/O Pol Gallagher ZAP Architecture**

**Location: Hillcrest Lower Kindlestown, Greystones, Co Wicklow**

### DIRECTOR OF SERVICES ORDER NO. 1220/2022

A question has arisen as to whether or not – Lower ground floor bedrooms extended to add 16.4msq, - Changes to 3 windows on lower ground floor southern elevation, underground light well not visible from the road. – Extension of 3.2msq to ground floor over gap in front elevation. – Larger windows. – Rooflight & Velux windows over eastern side of dwelling. – Purposed retaining wall to side of dwelling. – Purposed bridge to front door, at Hillcrest Lower Kindlestown, Greystones, Co Wicklow is or is not exempted development.

#### Having regard to:

- The details submitted with this application 27<sup>th</sup> June 2022.
- Sections 2 & 3 of the Planning & Development Act 2000(as amended).
- Schedule 4(1)(h), of the Planning & Development Act 2000(as amended).
- Article 6(1) Planning & Development Regulations, 2001(as amended).
- Article 9 (1); Planning & Development Regulations, 2001(as amended).
- Part 1 (Classes 1, 5 & 6) of Schedule 2 Planning & Development Regulations, 2001(as amended):

#### Main Reasons with respect to Section 5 Declaration:

1. The changes consisting of the
  - Lower ground floor bedrooms extended to add 16.4msq
  - Changes to 3 windows on lower ground floor southern elevation, underground light well not visible from the road.
  - Extension of 3.2msq to ground floor over gap in front elevation.
  - Larger windows
  - Rooflight & velux windows over eastern side of dwelling.


Would not materially affect the external appearance of the structure so as to render the appearance inconsistent with the character of the structure or of neighbouring structures. The development would therefore come within the scope of section 4(1)(h) of the Planning & Development Act 2000 (as amended) and the extension would not exceed 40msq in area & would come under Part 1 Classes 1, of Schedule 2 Planning & Development Regulations, 2001(as amended).

This document is available in alternative formats on request*

Ba chóir gach comhfhreagras a sheoladh chuig an Stiúrthóir Seirbhíse, Forbairt Pleanála agus Comhshaol.  
All correspondence should be addressed to the Director of Services, Planning Development & Environment.





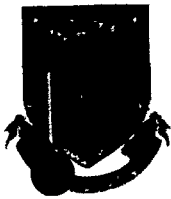

# Comhairle Contae Chill Mhantáin Wicklow County Council

Forbairt Pleanála agus Comhshaol  
Planning Development and Environment

Áras An Chontae / County Buildings  
Cill Mhantáin / Wicklow  
Guthán / Tel: (0404) 20148  
Faics / Fax: (0404) 69462  
Rphost / Email: [plandev@wicklowcoco](mailto:plandev@wicklowcoco)  
Suíomh / Website: [www.wicklow.ie](http://www.wicklow.ie)

2. The changes consisting of
- Proposed retaining wall to side of dwelling
  - Proposed bridge to front door.

Would not materially alter the external appearance of the building so as to render the appearance inconsistent with the character of the structure.

The development would not come within the scope of section 4(1)(h) of the Planning & Development Act 2000(as amended) and would not, given the height of the retaining wall and the differences in ground levels, fall under the conditions and Limitations of Part 1 (Classes 5 & 6) of Schedule 2 Planning & Development Regulations, 2001 (as amended).

The Planning Authority considers that Lower ground floor bedrooms extended to add 16.4msq, - Changes to 3 windows on lower ground floor southern elevation, underground light well not visible from the road. - Extension of 3.2msq to ground floor over gap in front elevation. - Larger windows. - Rooflight & Velux windows over eastern side of dwelling at Hillcrest Lower Kindlestown, Greystones, Co Wicklow is development but is exempted development

The Planning Authority considers that Purposed retaining wall to side of dwelling & Purposed bridge to front door at Hillcrest Lower Kindlestown, Greystones, Co Wicklow is development & is NOT exempted development

Signed:

ADMINISTRATIVE OFFICER  
PLANNING DEVELOPMENT & ENVIRONMENT

Dated <sup>nd</sup>22 July 2022







**WICKLOW COUNTY COUNCIL  
SECTION 5 DECLARATION REPORT**

---

**Ref:** EX41/2022  
**Name:** Oisín Gibson  
**Development:** works/alterations  
**Location:** Hillcrest, Lower Kindelstown, Greystones

---

**Site Details:**

**Service Road**

**Details:** The subject site comprises an existing two storey dwelling on a site that slopes steeply downhill from the road.

**Zoning RE:** To protect, provide for and improve residential amenities of adjoining properties and areas while allowing for infill residential development that reflects the established character of the area in which it is located.

No previous planning history.

**Google Images and Photographs:**



**Relevant Planning History:**

None

**Question:**

In Section 3(iv) of the application form, the applicants have outlined details of the proposal.

Whether or not the following alterations to Hillcrest, Lower Kindelstown is development and is exempted development:



- lower ground floor bedrooms extended to add 16.4msq
- Changes to 3 windows on lower ground floor southern elevation , underground light well not visible from the road.
- Extension of 3.2msq to ground floor over gap in front elevation
- Larger windows
- Rooflight and velux windows over eastern side of dwelling.

From the plans and particulars submitted the applicants have shown changes which are not included in the summary of the changes /alterations proposed.

It is not clear if this is to be the subject of a separate application, however for clarity I will include these additional changes in this report.

- Proposed retaining wall to side of dwelling
- Proposed bridge to front door.

### Legislative Context

#### Planning and Development Act 2000 (as amended)

Section 3(1) states the following in respect of:

'development': "In this Act, 'development' means, except where the context otherwise requires, the carrying out of any works on, in, over or under land or the making of any material change in the use of any structures or other land."

Section 2(1) states the following in respect of:

'works" includes Any act or operation of construction, excavation, demolition, extension, alteration, repair or renewal..."

"Structure" means any building, structure, excavation, or other thing constructed or made on, in or under any land, or any part of a structure so defined, and-

- Where the context so admits, includes the land on, in or under which the structure is situate, and
- In relation to a "protected structure" or proposed protected structure, includes –
  - The interior of the structure
  - The land lying within the curtilage of the structure
  - Any other structures lying within that curtilage and their interiors, and
  - All fixtures and features which form part of the interior of the structure or structures referred to in subparagraph (i) or 9iii)

Section 4 Sets out the types of works that while considered 'development', can be considered 'exempted development' for the purposes of the Act.

The following are relevant for the purposes of this declaration:



**Section 2 (1)** defines works as including: "Any act or operation of construction, excavation, demolition, extension, alteration, repair or renewal";

**Section 4 (1)(a) to (l)** specifies various categories of development which shall be exempted for the purposes of the Act;

**Section 4 (1) (h)**

"development consisting of the carrying out of works for the maintenance, improvement or other alteration of any structure, being works which affect only the interior of the structure or which do not materially affect the external appearance of the structure so as to render the appearance inconsistent with the character of the structure or of neighbouring structures."

**Section 4(2)** Makes provision for ministerial regulations to set out further exemptions. The 2001 Planning Regulations as amended derive from this section and designate further works as being exempted development for the purposes of the act.

**-Planning and Development Regulations, 2001 (as amended):**

**Article 6(1)** states that certain classes of development which are specified in Schedule 2 shall be exempted development for the purposes of the Act, subject to compliance with any associated conditions and limitations;

**Article 9 (1)** states that certain development to which article 6 relates shall not be exempted development for the purposes of the Act, when certain instances apply;

**Part 1 (Classes 1-8) of Schedule 2** describes classes of development within the curtilage of a house, which are exempted development, provided that such development complies with the associated conditions and limitations;

**CLASS 1**

The extension of house, by the construction of or erection of an extension (including a conservatory) to the rear of the house or by the conversion for use as part of the house of any garage, store, shed of similar structure attached to the rear or to the side of the house.

**Conditions and Limitations:**

1. (a) Where the house has not been extended previously, the floor area of any such extension shall not exceed 40 square metres.  
(b) Subject to paragraph (a), where the house is terraced or semi-detached, the floor area of any extension above ground level shall not exceed 12 square metres.  
(c) Subject to paragraph (a), where the house is detached, the floor area of any extension above ground level shall not exceed 20 square metres.
2. (a) Where the house has been extended previously, the floor area of any such extension, taken together with the floor area of any previous extension or extensions constructed or erected after 1 October 1964, including those for which planning permission has been obtained, shall not exceed 40 square metres.  
(b) Subject to paragraph (a), where the house is terraced or semi-detached and has been extended previously, the floor area of any extension above ground level taken together with the

floor area of any previous extension or extensions above ground level constructed or erected after 1 October 1964, including those for which planning permission has been obtained, shall not exceed 12 square metres.

(c) Subject to paragraph (a), where the house is detached and has been extended previously, the floor area of any extension above ground level, taken together with the floor area of any previous extension or extensions above ground level constructed or erected after 1 October 1964, including those for which planning permission has been obtained, shall not exceed 20 square metres.

3. Any above ground floor extension shall be a distance of not less than 2 metres from any party boundary.
4. (a) Where the rear wall of the house does not include a gable, the height of the walls of any such extension shall not exceed the height of the rear wall of the house.  
(b) Where the rear wall of the house includes a gable, the height of the walls of any such extension shall not exceed the height of the sidewalls of the house.  
(c) The height of the highest part of the roof of any such extension shall not exceed, in the case of a flat roofed extension, the height of the eaves or parapet, as may be appropriate, or, in any other case, shall not exceed the height of the highest part of the roof of the dwelling.
5. The construction or erection of any such extension to the rear of the house shall not reduce the area of private open space, reserved exclusively for the use of the occupants of the house, to the rear of the house to less than 25 square metres.
6. (a) Any window proposed at ground level in any such extension shall not be less than 1 metre from the boundary it faces.  
(b) Any window proposed above ground level in any such extension shall not be less than 11 metres from the boundary it faces.  
(c) Where the house is detached and the floor area of the extension above ground level exceeds 12 square metres, any window proposed at above ground level shall not be less than 11 metres from the boundary it faces.

**CLASS 5** The construction, erection or alteration, within or bounding the curtilage of a house, of a gate, gateway, railing or wooden fence or a wall of brick, stone, blocks with decorative finish, other concrete blocks or mass concrete.

#### **Conditions and Limitations**

The height of any such structure shall not exceed 2 metres or, in the case of a wall or fence within or bounding any wooden fence or a wall of brick, stone, blocks with decorative finish, other concrete blocks or mass concrete, garden or other space in front of a house, 1.2 metres. 2. Every wall other than a dry or natural stone wall bounding any garden or other space shall be capped and the face of any wall of concrete or concrete block (other than blocks with decorative finish) which will be visible from any road, path or public area, including public open space, shall be rendered or plastered. 3. No such structure shall be a metal palisade or other security fence.



## CLASS 6

- (a) The construction of any path, drain or pond or the carrying out of any landscaping works within the curtilage of a house. (b) Any works within the curtilage of a house for— (i) the provision to the rear of the house of a hard surface for use for any purpose incidental to the enjoyment of the house as such, or, (ii) the provision of a hard surface in the area of the garden forward of the front building line of the house, or in the area of the garden to the side of the side building line of the house, for purposes incidental to the enjoyment of the house as such.

### Conditions and Limitations

The level of the ground shall not be altered by more than 1 metre above or below the level of the adjoining ground.

### Assessment

The first assessment must be whether or not the proposal outlined above constitutes development within the remit of Section 3 of the Planning and Development Act 2001. In this regard, Section 3 of the Planning and Development Act provides that:

“development” means, except where the context otherwise requires, the carrying out of any works on, in, over or under land or the making of any material change in the use of any structures or other land.

It should be noted that Section 2 of the Act defines works as:

“works” includes any act or operation of construction, excavation, demolition, extension, alteration, repair or renewal and, in relation to a protected structure or proposed protected structure, includes any act or operation involving the application or removal of plaster, paint, wallpaper, tiles or other material to or from the surfaces of the interior or exterior of a structure.

I am satisfied that the proposal would involve works to the existing structure and therefore the proposal does constitute development.

The second stage of the assessment is to determine whether or not the proposed development would be exempted development under the Planning and Development Act 2000 (as amended) or it's associated Regulations.

- lower ground floor bedrooms extended to add 16.4msq
- Changes to 3 windows on lower ground floor southern elevation , underground light well not visible from the road.
- Extension of 3.2msq to ground floor over gap in front elevation
- Larger windows
- Rooflight and velux windows over eastern side of dwelling:
- 

Following consideration of the proposed works I am satisfied that these works would not materially affect the external appearance of the structure so as to render the appearance inconsistent with the character of the structure or of neighboring structures. In this regard is noted that the appearance and design of the proposed building varies from many other buildings along the road.

The dwelling is detached and the total floor area of the extensions does not exceed 40msq and is less than 20msq at first floor level.

- Proposed retaining wall to side of dwelling
- Proposed bridge to front door.

These proposed works would alter the external appearance of the building. The proposed bridge extends beyond the front elevation of the existing dwelling and the proposed retaining wall to the side elevation. From the plans submitted it would appear that the new retaining wall exceeds 2m in height and the ground level at lower ground level would be altered by over 1m.

Recommendation

**With respect to the query under Section 5 of the Planning and Development Act 2000, as to whether**

The following alterations to Hillcrest, Kindelstown Lower Greystones are development and are exempted development:

- lower ground floor bedrooms extended to add 16.4msq
- Changes to 3 windows on lower ground floor southern elevation , underground light well not visible from the road.
- Extension of 3.2msq to ground floor over gap in front elevation
- Larger windows
- Rooflight and velux windows over eastern side of dwelling.
- Proposed retaining wall to side of dwelling
- Proposed bridge to front door.

**The Planning Authority considers that:**

The following proposed changes to the building

- lower ground floor bedrooms extended to add 16.4msq
- Changes to 3 windows on lower ground floor southern elevation, underground light well not visible from the road.
- Extension of 3.2msq to ground floor over gap in front elevation
- Larger windows
- Rooflight and velux windows over eastern side of dwelling.

is development and is exempted development.

The following proposed changes to the building

- Proposed retaining wall to side of dwelling
- Proposed bridge to front door.



Is development and is not exempt development

**Main Considerations with respect to Section 5 Declaration:**

- The details submitted with this application 27<sup>th</sup> June 2022
- Sections 2 and 3 of the Planning and Development Act 2000(as amended).
- Schedule 4(1)(h), of the Planning and Development Act 2000(as amended).
- Article 6(1) Planning and Development Regulations, 2001 (as amended):
- Article 9 (1); Planning and Development Regulations, 2001 (as amended):
- Part 1 (Classes 1, 5 &6) of Schedule 2 Planning and Development Regulations, 2001 (as amended):

**Main Reasons with respect to Section 5 Declaration:**

- 1) The changes consisting of the
  - lower ground floor bedrooms extended to add 16.4msq
  - Changes to 3 windows on lower ground floor southern elevation , underground light well not visible from the road.
  - Extension of 3.2msq to ground floor over gap in front elevation
  - Larger windows
  - Rooflight and velux windows over eastern side of dwelling.

would not materially affect the external appearance of the structure so as to render the appearance inconsistent with the character of the structure or of neighboring structures. The development would therefore come within the scope of section 4(1)(h) of the Planning and Development Act 2000 (as amended) and the extension would not exceed 40msq in area and would come under Part 1 Classes 1, of Schedule 2 Planning and Development Regulations, 2001 (as amended).

- 2) The changes consisting of

- Proposed retaining wall to side of dwelling
- Proposed bridge to front door.

would materially alter the external appearance of the building so as to render the appearance inconsistent with the character of the structure .

The development would not come within the scope of section 4(1)(h) of the Planning and Development Act 2000 (as amended) and would not , given the height of the retaining wall and the differences in ground levels, fall under the conditions and Limitations of Part 1 (Classes 5 &6) of Schedule 2 Planning and Development Regulations, 2001 (as amended).



Lyndsey Blackmore  
Assistant Planner  
21/07/2022

Agreed  
BL  
DOS  
22/7/22

Paul  
21/7/22

# **MEMORANDUM**

## **WICKLOW COUNTY COUNCIL**

---

**TO: Lyndsey Blackmore  
Executive Planner**

**FROM: Crystal White  
Assistant Staff Officer**

---

**RE:- Ex 41/2022- Declaration in accordance with Section 5 of the  
Planning & Development Acts 2000 (as amended)  
Oisin Gibson C/O Pol Gallagher Zap Architecture Purposed  
works/alterations at Hillcrest Lower, Kindelstown, Greystones, Co  
Wicklow**

I enclose herewith for your attention application for Section 5 Declaration received 27<sup>th</sup> June 2022.

The due date on this declaration is the 24<sup>th</sup> July 2022.

---

**Senior Staff Officer  
Planning Development & Environment**





# Comhairle Contae Chill Mhantáin Wicklow County Council

**Forbairt Pleanála agus Comhshaol  
Planning Development and Environment**

Áras An Chontae / County Buildings  
Cill Mhantáin / Wicklow  
Guthán / Tel: (0404) 20148  
Faics / Fax: (0404) 69462  
Rphost / Email: [plandev@wicklowcoco.ie](mailto:plandev@wicklowcoco.ie)  
Suíomh / Website: [www.wicklow.ie](http://www.wicklow.ie)

Oisin Gibson  
C/O Pol Gallagher ZAP Architecture  
369 High Street  
London  
E15 4QZ  
UK

**28<sup>th</sup> June 2022**

**Re: EX 41/2022 Application for a Declaration in accordance with  
Section 5 of the Planning and Development Acts 2000 (as  
amended) – Purposed works/alterations at Hillcrest, Lower  
Kindelstown, Greystones, Co Wicklow**

**A Chara,**

I wish to acknowledge receipt of application in the above regard received on the 27<sup>th</sup> of June 2022 and to advise that a decision is due on this application on the 24<sup>th</sup> July 2022.

**Mise le meas**

---

**SENIOR STAFF OFFICER  
PLANNING DEVELOPMENT & ENVIRONMENT**

*Tá an doiciméad seo ar fáil i bhformáidí eile ar iarratas  
This document is available in alternative formats on request*

Ba chóir gach comhfhreagras a sheoladh chuig an Stiúrthóir Seirbhísí, Forbairt Pleanála agus Comhshaol.  
All correspondence should be addressed to the Director of Services, Planning Development & Environment.



Wicklow County Council  
County Buildings  
Wicklow  
0404-20100

09/06/2014 14:15:12

Receipt No. : L1/308943/296114  
\*\*\*\*\* REPRINT \*\*\*\*\*

OISIN GIBSON  
HILLCREST  
KINDLESTOWN  
GREYSTONES  
CO.WICKLOW

EXEMPTION CERTIFICATES	80.00
GOODS	80.00
VAT Exempt/Non-vatable	

Total : 80.00 EUR

Tendered :  
Credit Card 80.00  
REF:OISIN GIBSON

Change : 0.00

Issued By : Cashier5MW  
From : Revenue Section  
Vat reg No.0015233H





**Wicklow County Council**  
**County Buildings**  
**Wicklow**  
**Co Wicklow**  
**Telephone 0404 20148**  
**Fax 0404 69462**

**Office Use Only**

Date Received \_\_\_\_\_

Fee Received \_\_\_\_\_

**APPLICATION FORM FOR A  
DECLARATION IN ACCORDANCE WITH SECTION 5 OF THE PLANNING &  
DEVELOPMENT ACTS 2000(AS AMENDED) AS TO WHAT IS OR IS NOT  
DEVELOPMENT OR IS OR IS NOT EXEMPTED DEVELOPMENT**

**1. Applicant Details**

- (a) Name of applicant: Mr Oisin Gibson  
Address of applicant: \_\_\_\_\_


Note Phone number and email to be filled in on separate page.

**2. Agents Details (Where Applicable)**

- (b) Name of Agent (where applicable) Pol Gallagher ARB RIBA M.ARCH, B.ARCH  
Address of Agent : ZAP Architecture, 369 High Street, London E15 4QZ, UK

Note Phone number and email to be filled in on separate page.

**3. Declaration Details**

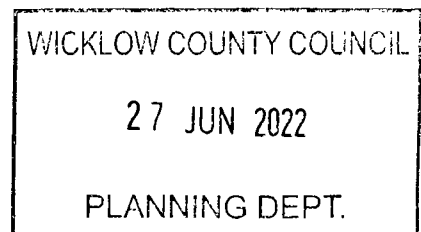

i. Location of Development subject of Declaration THE DEVELOPMENT IS LOCATED IN A63 Y765, HILLCREST, LOWER KINDELSTOWN - GREYSTONES.

ii. THIS EXEMPT ALTERATIONS TO THIS FAMILY HOME ARE BY VIRTUE OF UPDATING AN OLD HOUSE TO FULLY ENJOY FAMILY LIFE IN THE VICINITY, BY EXTENDING THE BEDROOMS AND DINING AREA FOR MODERN FAMILY LIVING. THE WINDOW WIDENING IS ALL ABOUT ENJOYING THE VIEWS TO THE WATER ON THE EASTERN ELEVATION.

iii. Are you the owner and/or occupier of these lands at the location under i. above ? Yes

iii. If 'No' to ii above, please supply the Name and Address of the Owner, and or occupier\_\_\_\_\_

\_\_\_\_\_  
\_\_\_\_\_

iv. Section 5 of the Planning and Development Act provides that : If any question arises as to what, in any particular case, is or is not development and is or is not exempted development, within the meaning of this act, any person may, on payment of the prescribed fee, request in writing from the relevant planning authority a declaration on that question. You should therefore set out the query for which you seek the Section 5 Declaration *Additional details may be submitted by way of separate submission. WE HAVE SUPPLIED A ONE PAGE SUMMARY OF WHAT IS CONSIDERED EXAMPT DEVELOPMENT (for ease of understanding the changes)*

v. Indication of the Sections of the Planning and Development Act or Planning Regulations you consider relevant to the Declaration THIS IS SUMMARISED IN ATTACHMENT 'EXEMPT DEVELOPMENT SUMMARY REV A

*Additional details may be submitted by way of separate submission.*  
SEE ATTACHMENT


vi. Does the Declaration relate to a Protected Structure or is it within the curtilage of a Protected Structure ( or proposed protected structure) ?\_N/A

vii. List of Plans, Drawings submitted with this Declaration Application FULL DRAWING PACK ATTACHED SHOWING EXEMPTED DEVELOPMENT ALTERATIONS IN COLOURED GREEN LINES - LABELLED PERMITTED DEVELOPMENT

'PROPOSED DESIGN 7th April 2022'

viii. Fee of € 80 Attached ? YES

Signed : \_\_ Dated : 11th May 2022

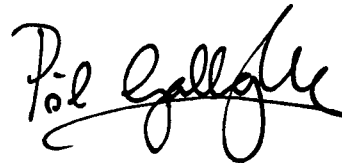

**Additional Notes :**

As a guide the minimum information requirements for the most common types of referrals under Section 5 are listed below :

- A. Extension to dwelling - Class 1 Part 1 of Schedule 2
  - Site Location Map - ATTACHED
  - Floor area of structure in question - whether proposed or existing. - SHOWN ON ATTACHED PACK
  - Floor area of all relevant structures e.g. previous extensions. - SHOWN ON ATTACHED PACK
  - Floor plans and elevations of relevant structures. - SHOWN ON ATTACHED PACK
  - Site Layout Plan showing distance to boundaries, rear garden area, adjoining dwellings/structures etc. - SHOWN ON ATTACHED PACK
- B. Land Reclamation -



Wednesday, 11 May 2022

## **SECTION 5 - EXEMPT DEVELOPMENT LOCATED AT:**

**A63 Y765, HILLCREST, LOWER KINDELSTOWN - GREYSTONES, CO. WICKLOW**

---

### **SUMMARY OF CHANGES / ALTERATIONS CONSIDERED 'EXEMPT' BY THE ARCHITECT.**

- A. Lower ground floor bedrooms extended to add 16.4m<sup>2</sup> (ie larger bedroom)
- B. 3 windows altered on lower ground floor southern elevation (to create more usability and natural light within the 3 compartmentalised spaces - this is under the ground level in a light well and not visible from the street).
- C. Ground floor - dining area created by extending 3.2m over gap in front elevation. (This squares off the front of the house and allows a dining area overlooking the sea view, no worse than the existing overlooking from the existing kitchen area.
- D. Larger windows proposed to enjoy better the sea view over Greystones harbour. (The existing windows offer the same aspect but are not full width appreciating the view to the maximum).
- E. Glazed rooflight over the proposed new dining space and Velux windows proposed in the existing pitched roof to the Eastern side. This allows morning light to penetrate into the kitchen / dining space from above).

## **WICKLOW COUNTY COUNCIL GUIDANCE ON THE ABOVE DESIGN MOVES**

### **CLASS 1 - Extension of a house**

The following is a list of design moves that are exempted from the requirement for planning permission under the Planning and Development Act 2000 and the Planning and Development Regulations 2001. It is important to note that these design moves are only exempted from the requirement for planning permission and do not exempt the development from the requirements of the Building Regulations or the Fire Safety Regulations.

1. 1. (a) Where the house has not been extended previously, the floor area of any such extension shall not exceed 40 square metres. (c) Subject to paragraph (a), where the house is detached, the floor area of any extension above ground level shall not exceed 20 square metres.
2. The design proposal does not exceed 40 square meters and does not exceed 20 square meters above ground level.
3. 3. Any above ground floor extension shall be a distance of not less than 2 metres from any party boundary.
4. The above ground floor extension is not distanced less than 2 meters from any party boundary.
5. 4. (b) Where the rear wall of the house includes a gable, the height of the walls of any such extension shall not exceed the height of the side walls of the house.
6. The height of the walls of the proposed extension does not exceed the height of the side walls.
7. 5. The construction or erection of any such extension to the rear of the house shall not reduce the area of private open space, reserved exclusively for the use of the occupants of the house, to the rear of the house to less than 25 square metres.
8. The proposed extension to the rear does reduce the area of private open space less than 25 square meters
9. 6. (a) Any window proposed at ground level in any such extension shall not be less than 1 metre from the boundary it faces.
10. Any proposed window at ground level in proposed extension is not located less than 1 meter from the boundary it faces.
11. 7. The roof of any extension shall not be used as a balcony or roof garden.
12. The roof of proposed extension is not used as a balcony nor roof garden.

**SOURCE:** Part 1: Planning Regulations, <https://www.wicklow.ie/Living/Services/Planning/Planning-Applications/Exempted-Development>

HILLCREST  
A63 Y765, HILLCREST, LOWER KINDELSTOWN, IRELAND  
EXISTING DRAWINGS



7th April 2022



# SITE INTRODUCTION



# AERIAL VIEW OF THE SITE





# SITE BOUNDARY





# SITE PHOTO





# SITE PHOTOS





# TERRAIN SECTION

ACCESS FROM THE STREET

STAIRS TO THE GARDEN AND GF ENTRANCE



EXISTING DRAWINGS



**SITE BOUNDARY DRAWING**



UNCONTROLLED INFORMATION

It is the duty of the recipients of electronic transmissions to be aware that their system may be corrupted by the opening of any such transmission and that they be satisfied that measures are in place to prevent such an occurrence.

No responsibility or liability whatsoever will be accepted by ZAP if the recipient's computer system is corrupted by information transmitted from ZAP computers and/or for any delays or other losses arising out of or caused by transmission.

**Viruses:** Although we have taken steps to ensure that this e-mail and attachments are free from any virus, we advise that in keeping with good computing practice the recipient should ensure they are actually virus free.

**Confidentiality:** This information is intended for the named recipients only and may be confidential. If it has come to you in error you must take no action based on the contents, nor must you copy or show them to anyone; please notify ZAP and highlight the error.

Please note that we work natively in AutoCAD which produces dwg format drawings and we are aware that line styles do not convert correctly between dwg and dgn formats. We therefore cannot guarantee the completeness or accuracy of the information in the issued dwg files and therefore the issued pdfs should always be used as a reference for the validity and accuracy of the information.

The contents of these drawings have been prepared solely for their use on this project and no other person or organisation should place reliance upon this information.

ZAP

All survey information inherited and carried over  
ICELABZ

53 The Meadow Way, HA3 7BP  
tel: 0203 744 3020  
email: [info@icelabz.co.uk](mailto:info@icelabz.co.uk)

ZAP Architecture Ltd cannot be held responsible as to the accuracy of this survey information



NOTES:

1. Private Road
2. R761
3. Footpath
4. Hedge
5. Wooden Planting Area
6. Shelter Area
7. Shed
8. Mesh Wire Fence
9. Iron Fence
10. Gate
11. Wall
12. Bank
13. Chimney
14. Septic Tank

**EXISTING**

## PLANNING

HILLCREST

Subject	<b>SITE PLAN</b> A63 Y765, HILLCREST LOWER KINDELSTOWN, IRELAND
---------	---

Architects	ZAP Architecture 365 High Street, London E15 4QZ T: 020 32614000 E: info@zaparchitecture.com
------------	--

Project Code	Drawing Number	Rev.
--------------	----------------	------

2203	150	A
------	-----	---


Date 14.01.2022 Scale 1:200 at A3

— SITE BOUNDARY

[illegible]



EXISTING GROUND FLOOR PLAN

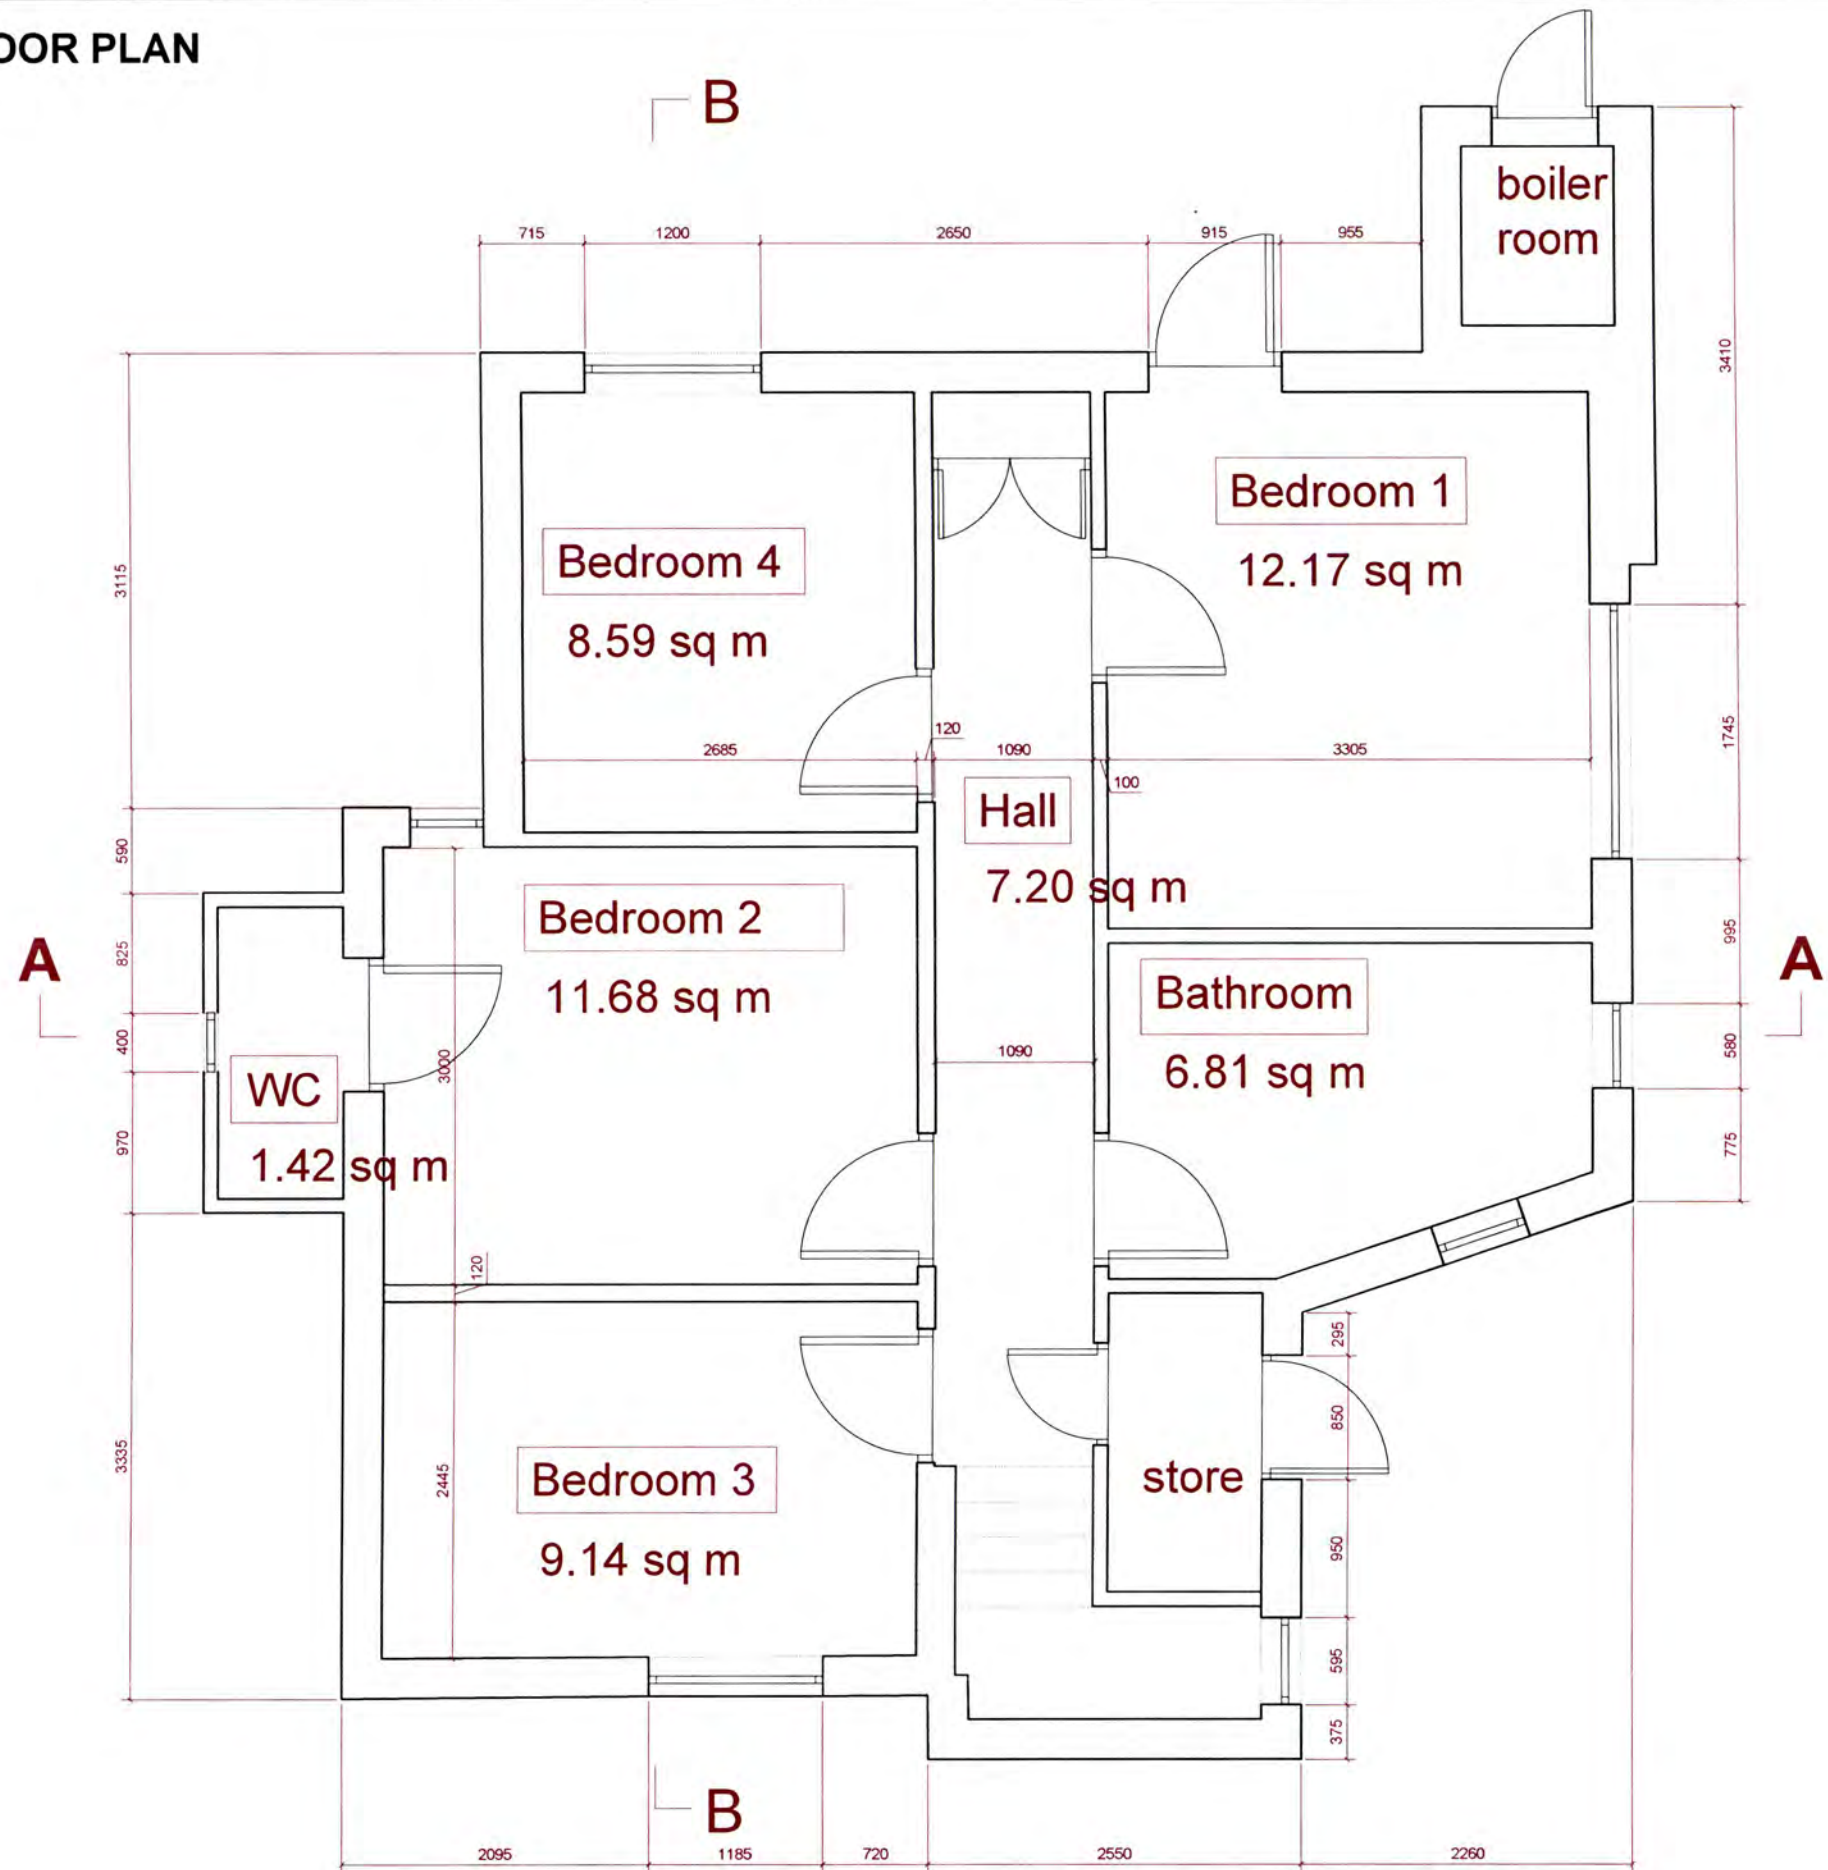

Disclaimer - Use of this Information  
UNCONTROLLED INFORMATION

This dwg document is an uncontrolled version issued to enable the recipient to use this information at their own risk. The issuer accepts no liability for any such use. Design development is ongoing and so may affect this dwg uncontrolled information. For controlled information refer to formally issued drawings and documents. USE AT RECIPIENT'S RISK ONLY

It is the duty of the recipients of electronic transmissions to be aware that their system may be corrupted by the opening of any such transmission and that they be satisfied that measures are in place to prevent such an occurrence.

No responsibility or liability whatsoever will be accepted by ZAP if the recipient's computer system is corrupted by information transmitted from ZAP computers and/or for any delays or other losses arising out of or caused by transmission.



Viruses: Although we have taken steps to ensure that this e-mail and attachments are free from any virus, we advise that in keeping with good computing practice the recipient should ensure they are actually virus free.

Confidentiality: This information is intended for the named recipients only and may be confidential. If it has come to you in error you must take no action based on the contents, nor must you copy or show them to anyone, please notify ZAP and highlight the error.

Please note that we work natively in AutoCAD which produces dwg format drawings and we are aware that line styles do not convert correctly between dwg and dgn formats. We therefore cannot guarantee the completeness or accuracy of the information in the issued dwg files and therefore the issued pdfs should always be used as a reference for the validity and accuracy of this information.

The contents of these drawings have been prepared solely for their use on this project and no other person or organisation should place reliance upon this information.

ZAP

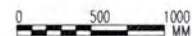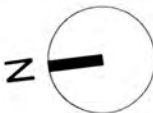


EXISTING  
PLANNING

Work Package	Cost Check	Info/Briefing	Tender	Contract	Construction	Date	Revision	Description	Drawn by	Date	Ref.	Revision	Drawn by	Project	Subject	Architects	Project Code	Drawing Number	Rev.
						13.01.2022	A	Existing Planning						HILLCREST	GROUND FLOOR PLAN	ZAP Architecture	2203	151	B
						18.01.2022	B	Changes made accordingly to client's comments on 18.01.2022						A63 Y765, HILLCREST	365 High Street, London, E15 4QZ	T: 020 3761 9890 E: info@zaparchitecture.com	Date	18.01.2022	Scale 1:50 at A3



EXISTING FIRST FLOOR PLAN

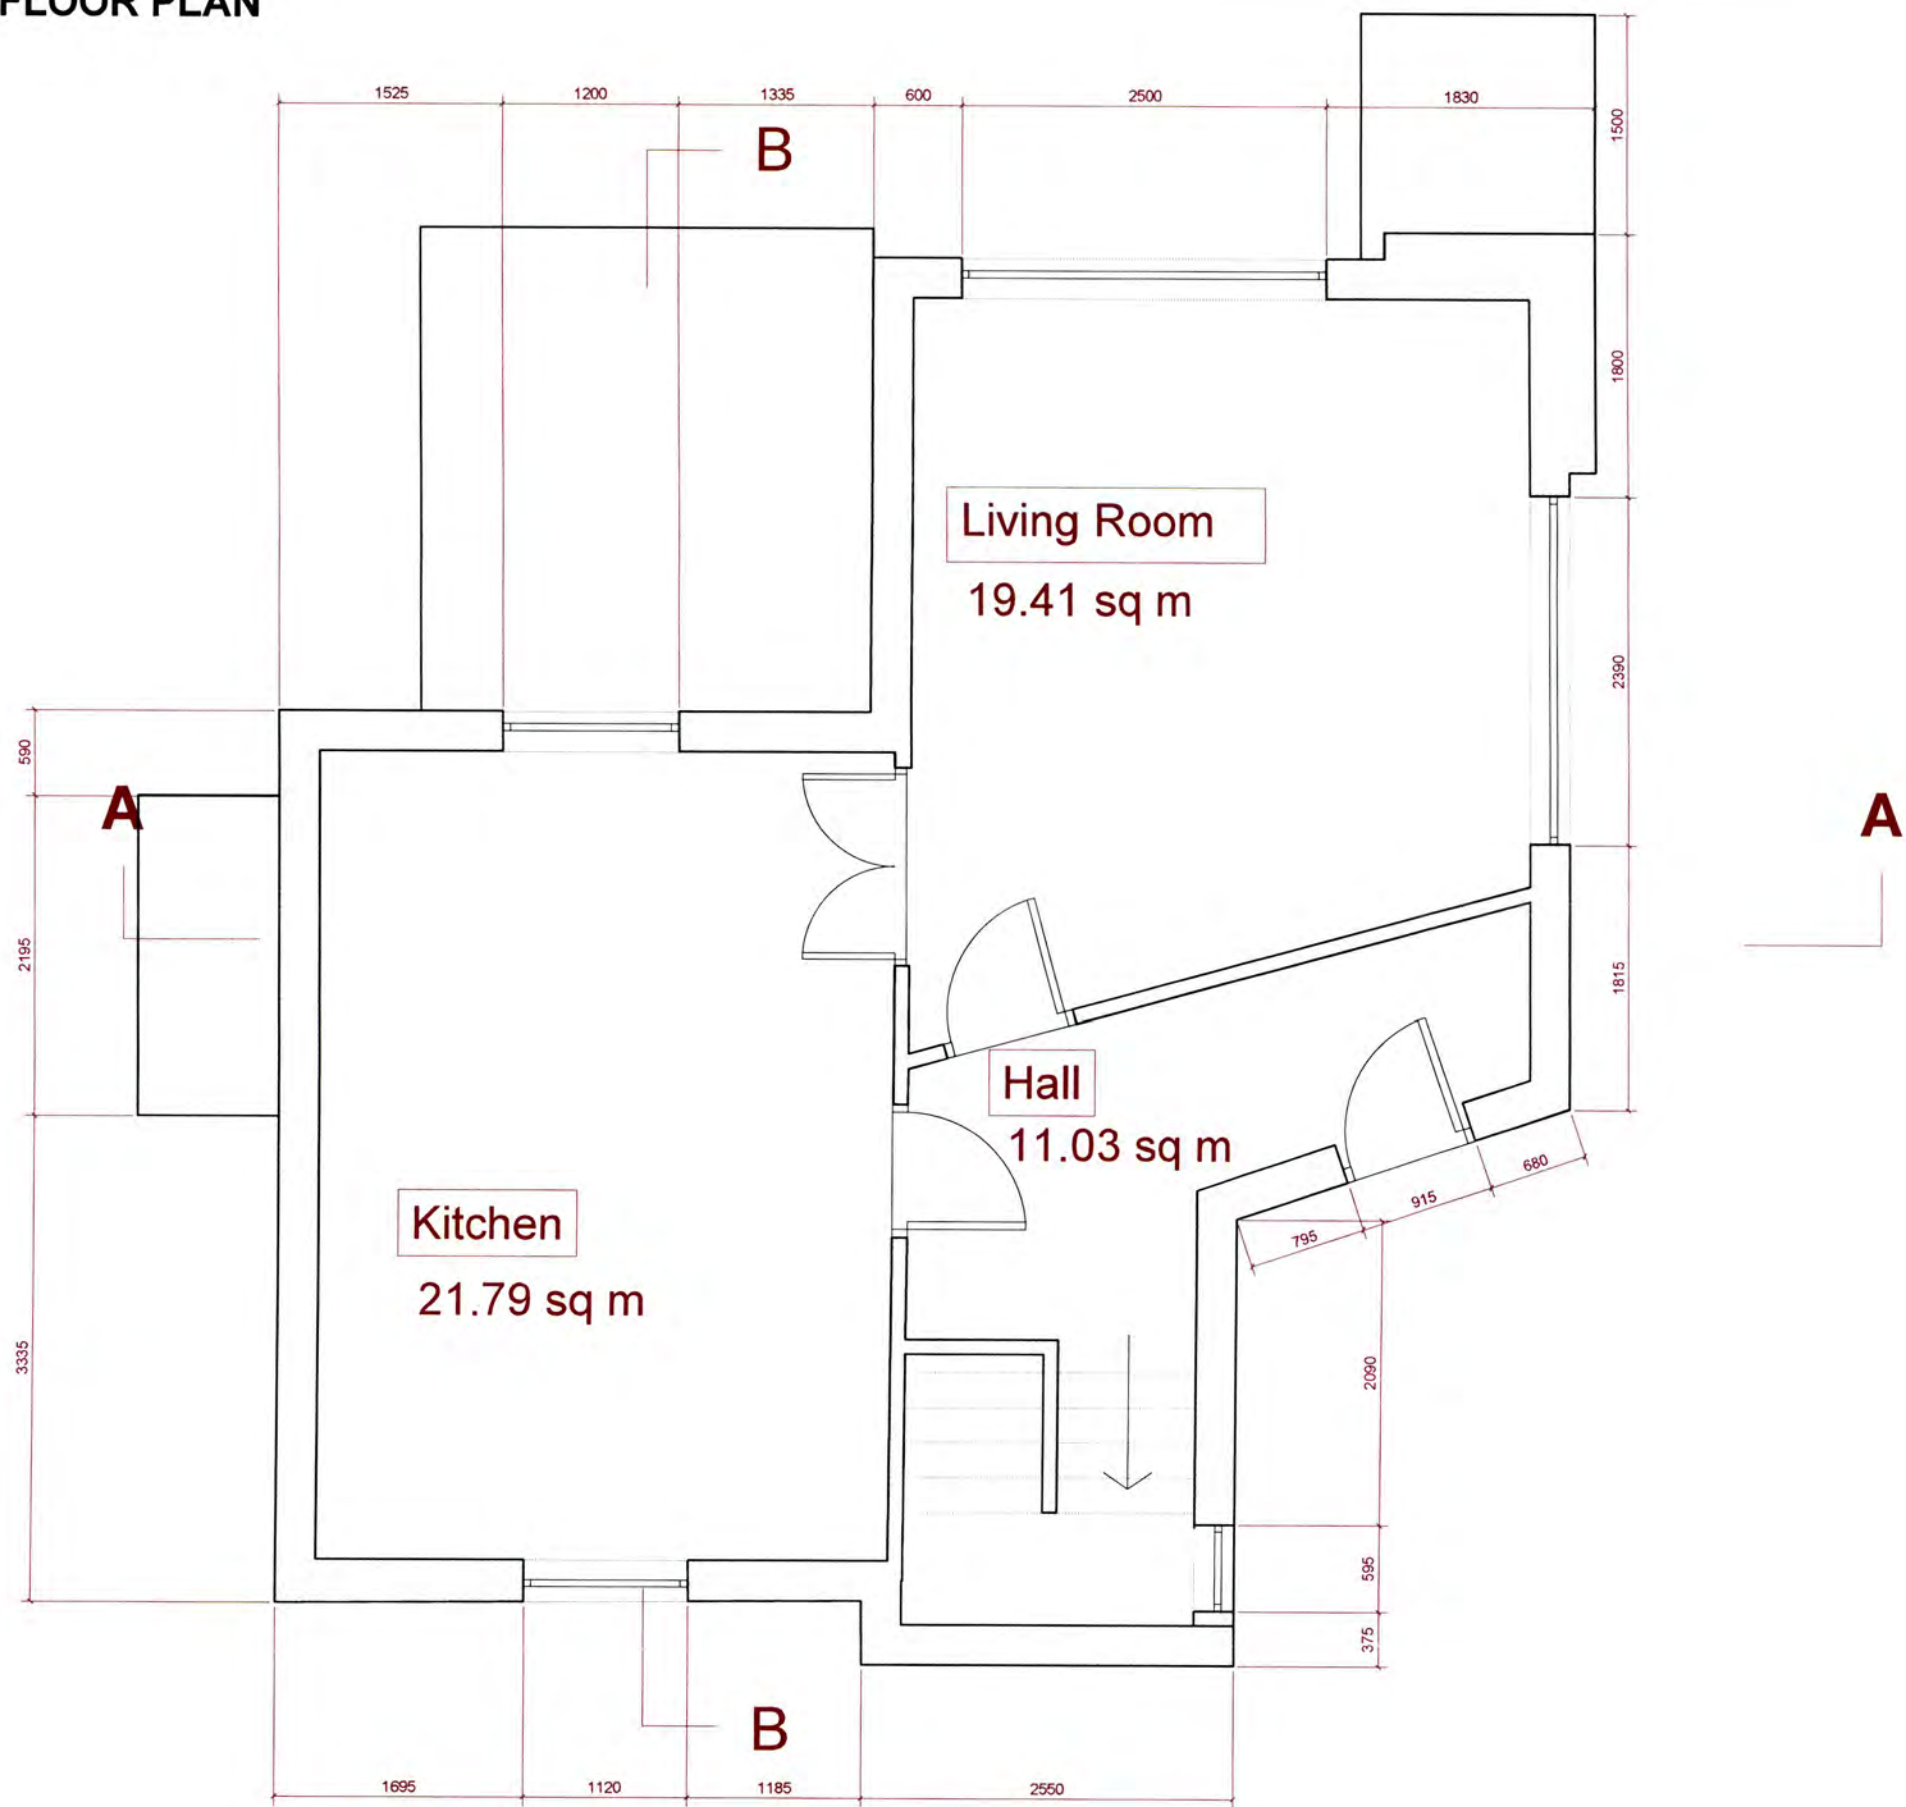

Disclaimer - Use of this Information  
UNCONTROLLED INFORMATION

This dwg document is an uncontrolled version issued to enable the recipient to use this information at their own risk. The issuer accepts no liability for any such use. Design development is ongoing and so may affect this dwg uncontrolled information. For controlled information refer to formally issued drawings and documents. USE AT RECIPIENT'S RISK ONLY

It is the duty of the recipients of electronic transmissions to be aware that their system may be corrupted by the opening of any such transmission and that they be satisfied that measures are in place to prevent such an occurrence.

No responsibility or liability whatsoever will be accepted by ZAP if the recipient's computer system is corrupted by information transmitted from ZAP computers and/or for any delays or other losses arising out of or caused by transmission.

Viruses. Although we have taken steps to ensure that this e-mail and attachments are free from any virus, we advise that in keeping with good computing practice the recipient should ensure they are actually virus free.

Confidentiality. This information is intended for the named recipients only and may be confidential. If it has come to you in error you must take no action based on the contents, nor must you copy or show them to anyone. Please notify ZAP and highlight the error.

Please note that we work natively in AutoCAD which produces dwg format drawings and we are aware that line styles do not convert correctly between dwg and dgn formats. We therefore cannot guarantee the completeness or accuracy of the information in the issued dwg files and therefore the issued pdfs should always be used as a reference for the validity and accuracy of this information.


The contents of these drawings have been prepared solely for their use on this project and no other person or organisation should place reliance upon this information.



All survey information inherited and carried out by ICELABZ

53 The Meadow Way, HA3 7BP  
tel: 0203 744 3020  
email: info@icelabz.co.uk

ZAP Architecture Ltd cannot be held responsible as to the accuracy of this survey information

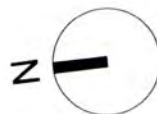

0 500 1000  
MM

EXISTING


PLANNIG

Work Package	Cost Check	Intubifiling	Tender	Contract	Construction	Date	Revision	Description	Drawn by	Date	Ref.	Revision	Drawn by	Project	Project Code	Drawing Number	Rev.
						13.01.2022	A	Existing Planning						HILLCREST	2203	152	B
						18.01.2022	B	Changes made accordingly to client's comments on 18.01.2022						Subject			
														Architects			
														ZAP Architecture			
														365 High Street, London, E15 4QZ			
														T: 020 3761 4990 E: info@zaparchitecture.com			

© Copyright ZAP Architecture Ltd. Registered in England number: 08413192 Registered address: 365 High St, London E15 4QZ. Use Figured Dimensions Only. All Dimensions to be checked on site. Original Drawing Size A3 (L)

Date 18.01.2022 Scale 1:50 at A3

EXISTING ROOF PLAN

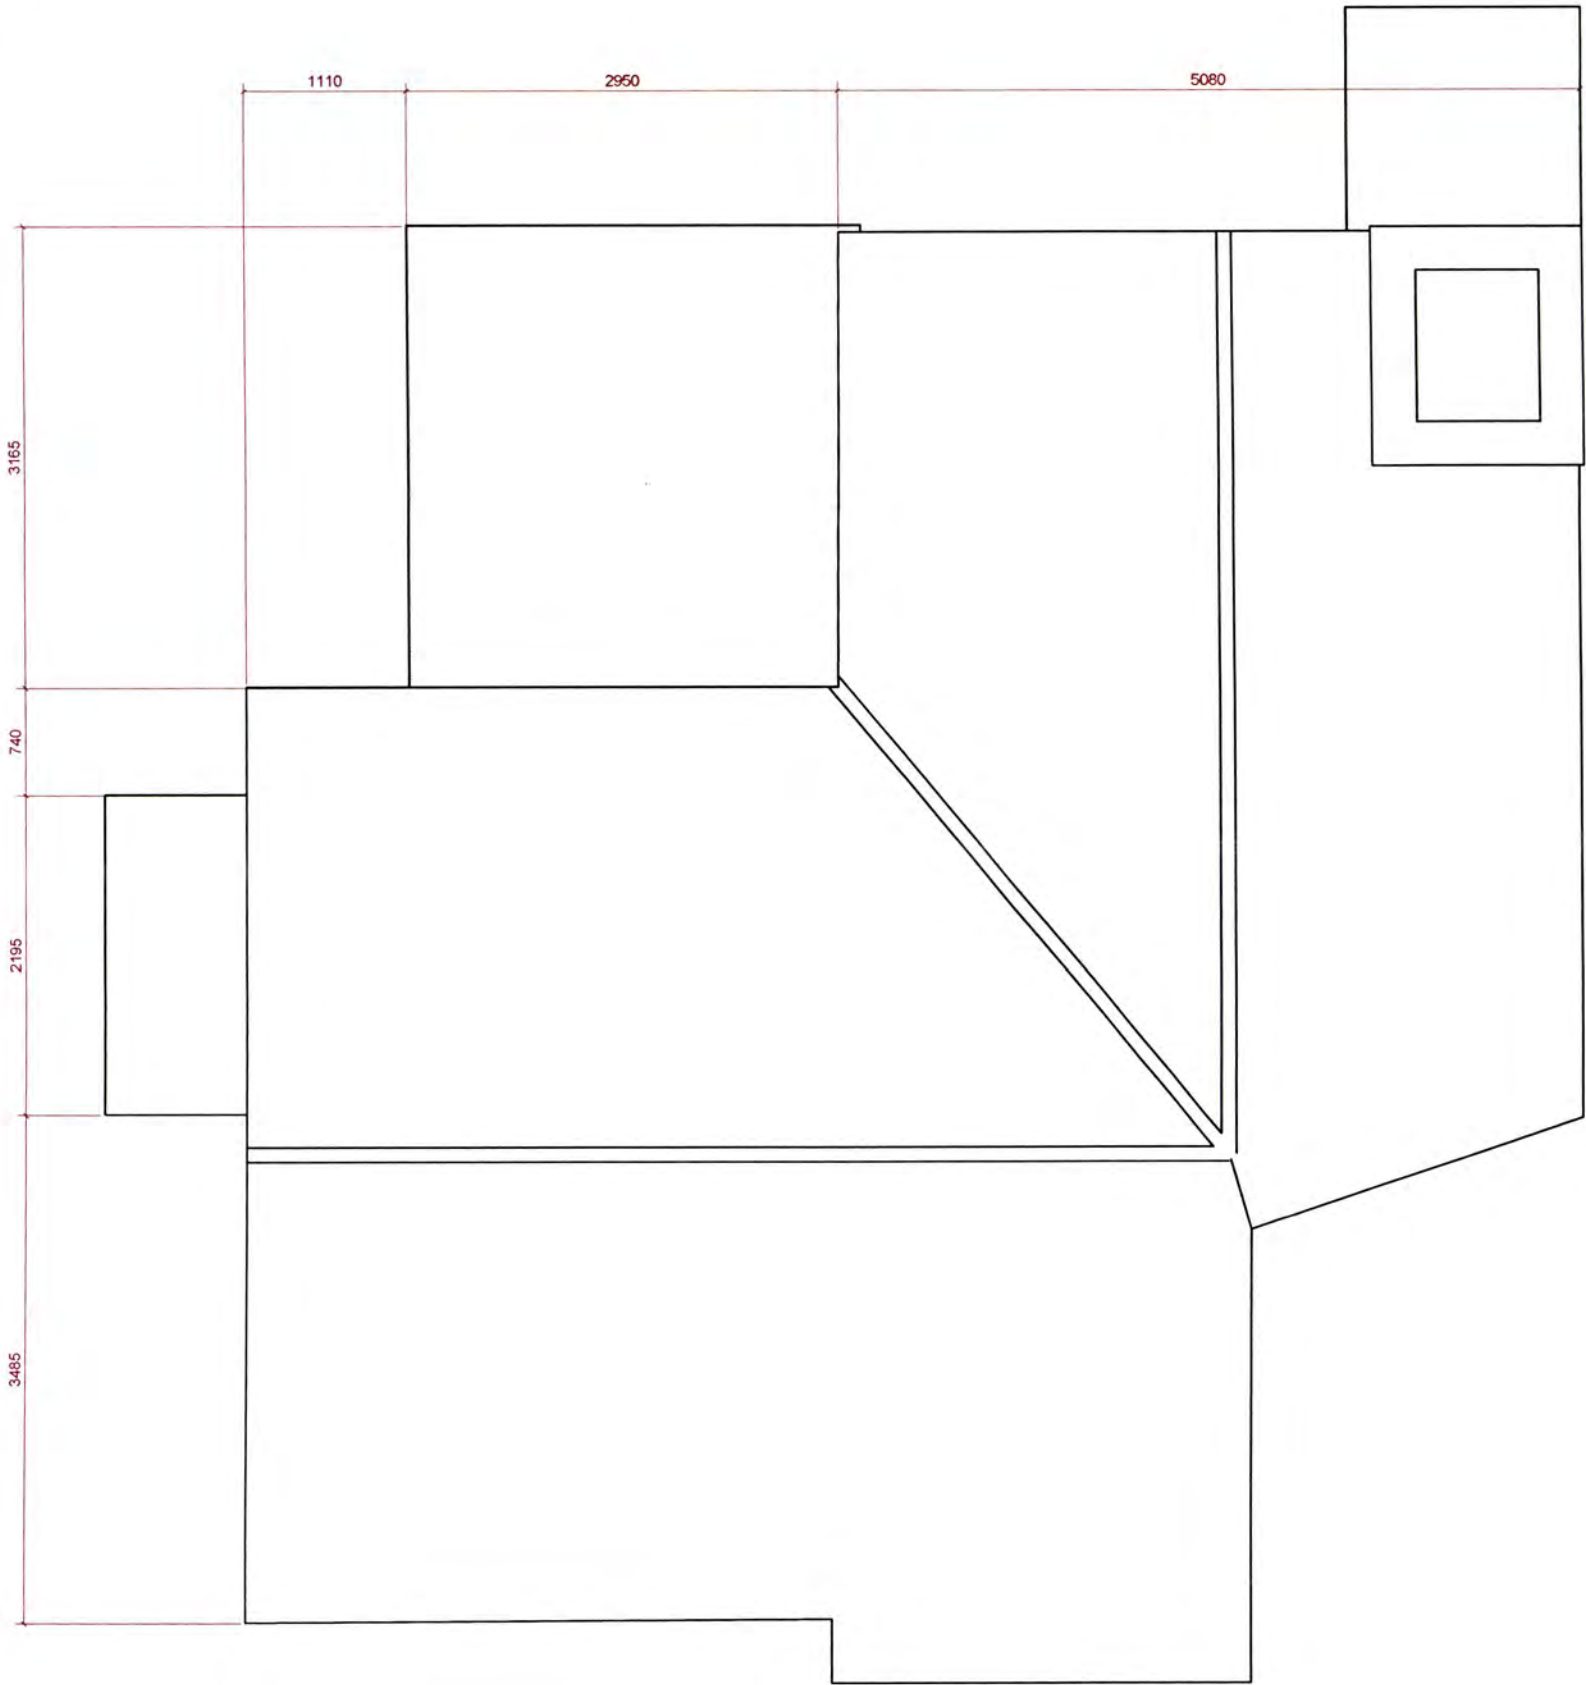

Disclaimer - Use of this Information  
UNCONTROLLED INFORMATION

This dwg document is an uncontrolled version issued to enable the recipient to use this information at their own risk. The issuer accepts no liability for any such use. Design development is ongoing and so may affect this dwg uncontrolled information. For controlled information refer to formally issued drawings and documents. USE AT RECIPIENT'S RISK ONLY

It is the duty of the recipients of electronic transmissions to be aware that their system may be corrupted by the opening of any such transmission and that they be satisfied that measures are in place to prevent such an occurrence.

No responsibility or liability whatsoever will be accepted by ZAP if the recipient's computer system is corrupted by information transmitted from ZAP computers and/or for any delays or other losses arising out of or caused by transmission.

Viruses. Although we have taken steps to ensure that this e-mail and attachments are free from any virus, we advise that in keeping with good computing practice the recipient should ensure they are actually virus free.

Confidentiality. This information is intended for the named recipients only and may be confidential. If it has come to you in error you must take no action based on the contents, nor must you copy or show them to anyone, please notify ZAP and highlight the error.



Please note that we work natively in AutoCAD which produces dwg format drawings and we are aware that line styles do not convert correctly between dwg and dgn formats. We therefore cannot guarantee the completeness or accuracy of the information in the issued dwg files and therefore the issued pdfs should always be used as a reference for the validity and accuracy of this information.

The contents of these drawings have been prepared solely for their use on this project and no other person or organisation should place reliance upon this information.



All survey information inherited and carried out by:  
ICELABZ  
53 The Meadow Way, HA3 7BP  
tel: 0203 744 3020  
email: info@icelabz.co.uk

ZAP Architecture Ltd cannot be held responsible as to the accuracy of this survey information

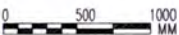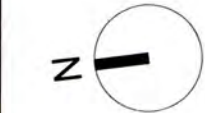

EXISTING  
PLANNIG

Work Package	Cost Check	Info/Briefing	Tender	Contract	Construction	Date	Revision	Description	Drawn by	Date	Ref.	Revision	Drawn by	Project	Subject	Architects	Project Code	Drawing Number	Rev.
						13.01.2022	A	Existing Planning						HILLCREST	ROOF PLAN	ZAP Architecture			
						18.01.2022	B	Changes made according to client's comments on 18.01.2022							A63 Y785, HILLCREST LOWER KINDELSTOWN, IRELAND	365 High Street, London, E15 4QZ T: 020 37614996 E: info@zaparchitecture.com	2203	153	B
																	Date	18.01.2022	Scale 1:50 at A3



EXISTING ELEVATION 01



### Disclaimer - Use of this Information

## UNCONTROLLED INFORMATION

This dwg document is an uncontrolled version issued to enable the recipient to use this information at their own risk.  
The issuer accepts no liability for any such use. Design development is ongoing and so may affect this dwg uncontrolled information.  
For controlled information refer to formally issued drawings and documents.  
**USE AT RECIPIENT'S RISK ONLY**

It is the duty of the recipients of electronic transmissions to be aware that their system may be corrupted by the opening of any such transmission and that they be satisfied that measures are in place to prevent such an occurrence.

No responsibility or liability whatsoever will be accepted by ZAP if the recipient's computer system is corrupted by information transmitted from ZAP computers and/or for any delays or other losses arising out of or caused by transmission.


Viruses. Although we have taken steps to ensure that this e-mail and attachments are free from any virus, we advise that in keeping with good computing practice the recipient should ensure they are actually virus free.

**Confidentiality:** This information is intended for the named recipients only and may be confidential. If it has come to you in error you must take no action based on the contents, nor must you copy or show them to anyone; please notify ZAP and highlight the error.

Please note that we work natively in AutoCAD which produces dwg format drawings and we are aware that line styles do not convert correctly between dwg and dgn formats. We therefore cannot guarantee the completeness or accuracy of the information in the issued dwg files and therefore the issued pdfs should always be used as a reference for the validity and accuracy of this information.

The contents of these drawings have been prepared solely for their use on this project and no other person or organisation should place reliance upon this information.

ZAP

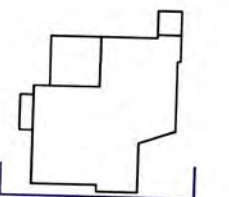

**EXISTING**

## PLANNING

Work Package						Cost Check	Info/Briefing	Tender	Contract	Construction	PLANNING										
-																					

## EXISTING ELEVATION 02

**Disclaimer - Use of this Information**

## UNCONTROLLED INFORMATION

This dwg document is an uncontrolled version issued to enable the recipient to use this information at their own risk.  
The issuer accepts no liability for any such use. Design development is ongoing and so may affect this dwg uncontrolled information.  
For controlled information refer to formally issued drawings and documents.  
**USE AT RECIPIENT'S RISK ONLY**

It is the duty of the recipients of electronic transmissions to be aware that their system may be corrupted by the opening of any such transmission and that they be satisfied that measures are in place to prevent such an occurrence.

No responsibility or liability whatsoever will be accepted by ZAP if the recipient's computer system is corrupted by information transmitted from ZAP computers and/or for any delays or other losses arising out of or caused by transmission.



**Viruses:** Although we have taken steps to ensure that this e-mail and attachments are free from any virus, we advise that in keeping with good computing practice the recipient should ensure they are actually virus free.

**Confidentiality:** This information is intended for the named recipients only and may be confidential. If it has come to you in error you must take no action based on the contents, nor must you copy or show them to anyone: please notify ZAP and highlight the error.

Please note that we work natively in AutoCAD which produces dwg format drawings and we are aware that line styles do not convert correctly between dwg and dgn formats. We therefore cannot guarantee the completeness or accuracy of the information in the issued dwg files and therefore the issued pdfs should always be used as a reference for the validity and accuracy of this information.

The contents of these drawings have been prepared solely for their use on this project and no other person or organisation should place reliance upon this information.

ZAP

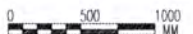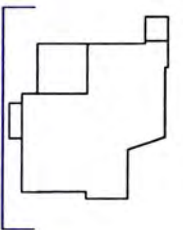


**EXISTING**

## PLANNING

Work Package	Cost Check	Info/Briefing	Tender	Contract	Construction	Date	Revision	Description	Drawn by	Date	Ref.	Revision	Drawn by	Project	HILLCREST	Project Code	Drawing Number	Rev.
						14.01.2022	A	Existing elevation						Subject	EXISTING ELEVATIONS HILLCREST, LOWER KINDELTOWN, IRELAND	2203	252	B
						18.01.2022	B	Changes made accordingly to client's comments on 18.01.2022						Architects	ZAP Architecture 305 High Street, London, E15 4QZ T: 020 37614999 E: info@zaparchitecture.com	Date	18.01.2022	Scale 1:50 at A3



**EXISTING ELEVATION 03**

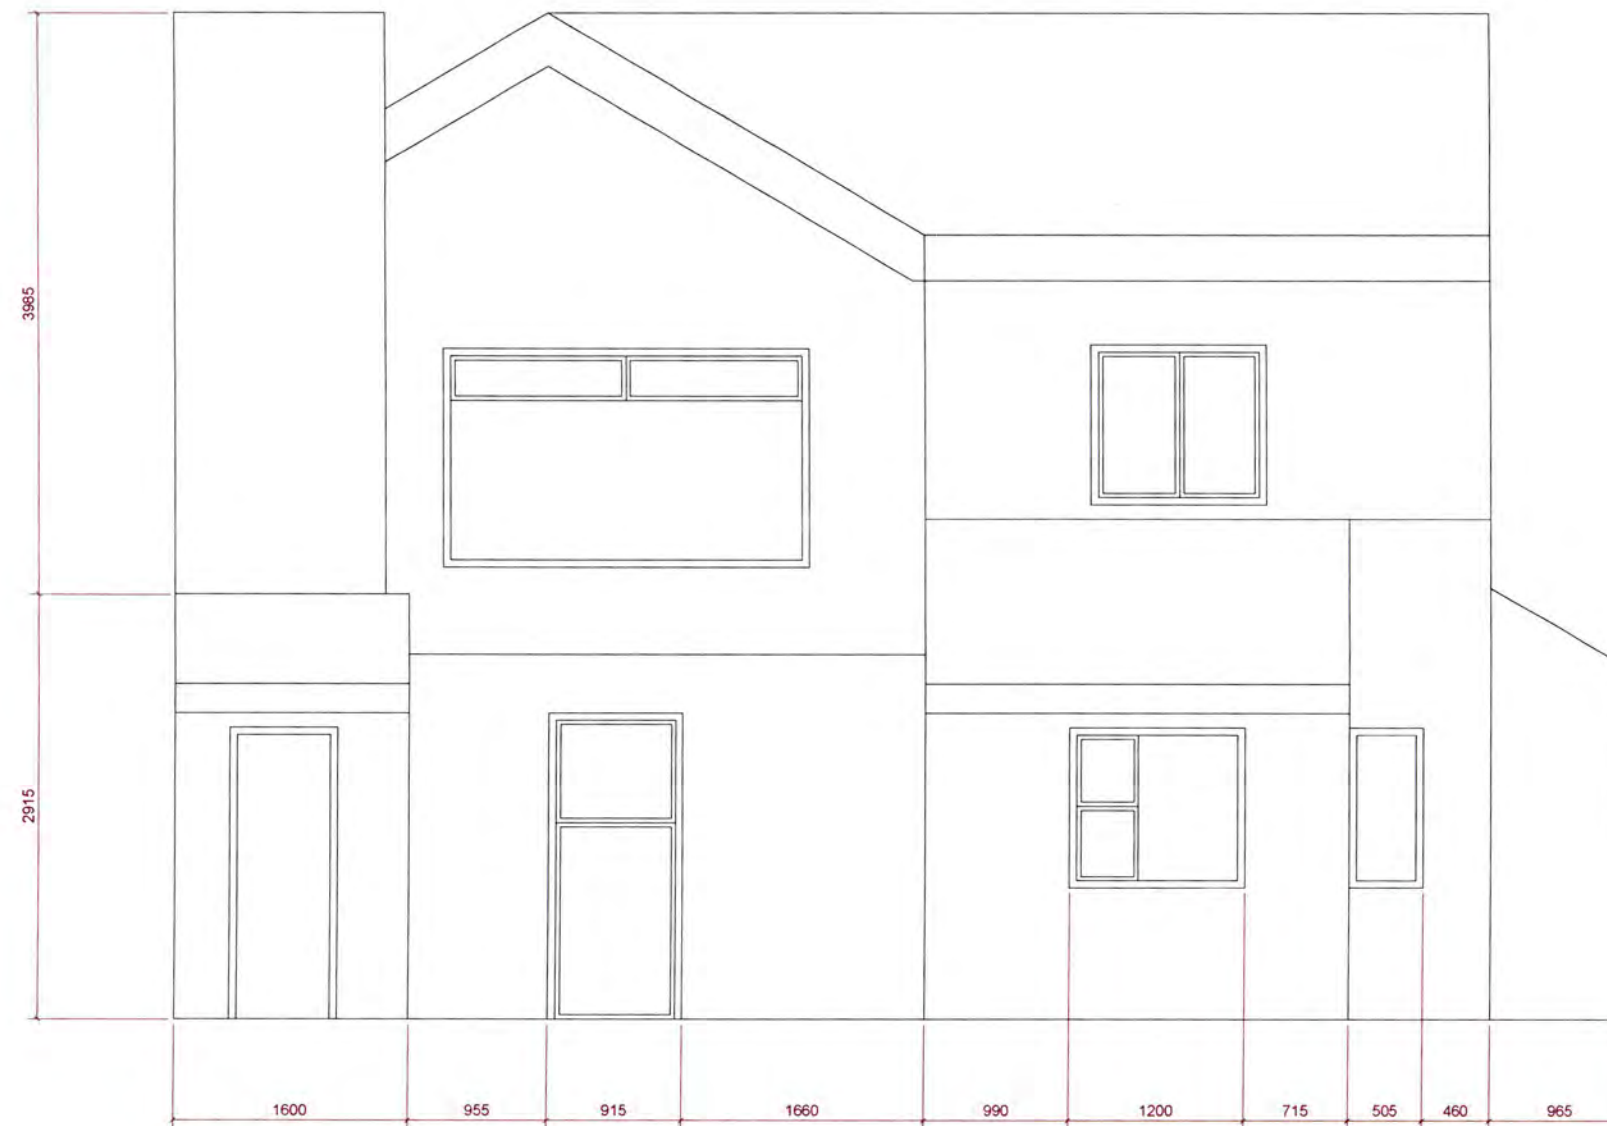

**Disclaimer - Use of this Information**  
**UNCONTROLLED INFORMATION**

This dwg document is an uncontrolled version issued to enable the recipient to use this information at their own risk.  
The issuer accepts no liability for any such use. Design development is ongoing and so may affect this dwg uncontrolled information.  
For controlled information refer to formally issued drawings and documents.  
**USE AT RECIPIENT'S RISK ONLY**

It is the *duty* of the recipients of electronic transmissions to be aware that their system may be corrupted by the receipt of a file via electronic transmission and that they be satisfied that measures are in place to prevent such an occurrence.

No responsibility or liability whatsoever will be accepted by ZAP if the recipient's computer system is corrupted by information transmitted from ZAP computers and/or for any delays or other losses arising out of or caused by transmissions.


Although we have taken steps to ensure that this e-mail and attachments are free from any virus, we advise that in keeping with good computing practice the recipient should ensure they are actually virus free.

**Confidentiality** This information is intended for the named recipients only and may be confidential. If it has come to you in error you must take no action on the information and return your copy or show them to anyone, please notify ZAP and highlight the error.

Please note that we work natively in AutoCAD which produces dwg format drawings and we are aware that some email clients convert incorrectly between dwg and dgn formats. We therefore cannot guarantee the completeness or accuracy of the information in the issued dwgs files and therefore the issued dwg should always be used as a reference for the validity and accuracy of this information.

The contents of these drawings have been prepared solely for their use on this project and no other person or organisation should place reliance upon this information.

ZAP

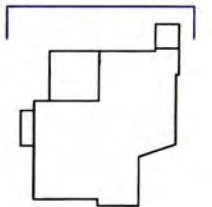

**EXISTING**

## PLANNING

Work Package	Cost Check	Info/Briefing	Tender	Contract	Construction	Date	Revision	Description	Drawn by	Date	Ref.	Revision	Drawn by	Project	HILLCREST	Project Code	Drawing Number	Rev.
-						18.01.2022	A	Existing elevation						Subject	EXISTING ELEVATIONS HILLCREST, LOWER KINDELTOWN, IRELAND	2203	253	B
						18.01.2022	B	Changes made according to client's comments on 18.01.2022						Architects	ZAP Architecture 365 High Street, London E15 4GZ T: 020 37614996 E: info@zaparchitecture.com	Date	18.01.2022	Scale 1:50 at A3

EXISTING ELEVATION 04



Disclaimer - Use of this Information  
UNCONTROLLED INFORMATION

This dwg document is an uncontrolled version issued to enable the recipient to use this information at their own risk. The issuer accepts no liability for any such use. Design development is ongoing and so may affect this dwg uncontrolled information. For controlled information refer to formally issued drawings and documents.  
USE AT RECIPIENT'S RISK ONLY

It is the duty of the recipients of electronic transmissions to be aware that their system may be corrupted by the opening of any such transmission and that they be satisfied that measures are in place to prevent such an occurrence.


No responsibility or liability whatsoever will be accepted by ZAP if the recipient's computer system is corrupted by information transmitted from ZAP computers and/or for any delays or other losses arising out of or caused by transmission.

Viruses: Although we have taken steps to ensure that this e-mail and attachments are free from any virus, we advise that in keeping with good computing practice the recipient should ensure they are actually virus free.

Confidentiality: This information is intended for the named recipients only and may be confidential. If it has come to you in error you must take no action based on the contents, nor must you copy or show them to anyone, please notify ZAP and highlight the error.

Please note that we work natively in AutoCAD which produces dwg format drawings and we are aware that line styles do not convert correctly between dwg and dgn formats. We therefore cannot guarantee the completeness or accuracy of the information in the issued dwg files and therefore the issued pdfs should always be used as a reference for the validity and accuracy of this information.

The contents of these drawings have been prepared solely for their use on this project and no other person or organisation should place reliance upon this information.

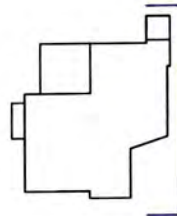


EXISTING  
PLANNING

Work Package	Cost Check	Info/Briefing	Tender	Contract	Construction	Date	Revision	Description	Drawn by	Date	Ref.	Revision	Drawn by	Project	Project Code	Drawing Number	Rev.	
-						14.01.2022	A	Existing elevation						HILLCREST EXISTING ELEVATIONS HILLCREST, LOWER KINDELSTOWN, IRELAND	2203	254	B	
						18.01.2022	B	Changes made according to client's comments on 18.01.2022										
														Architects ZAP Architecture 305 High Street, London, E15 4QZ T: 020 37614996 E: info@zaparchitecture.com	Date	18.01.2022	Scale	1:50 at A3



EXISTING SECTION AA

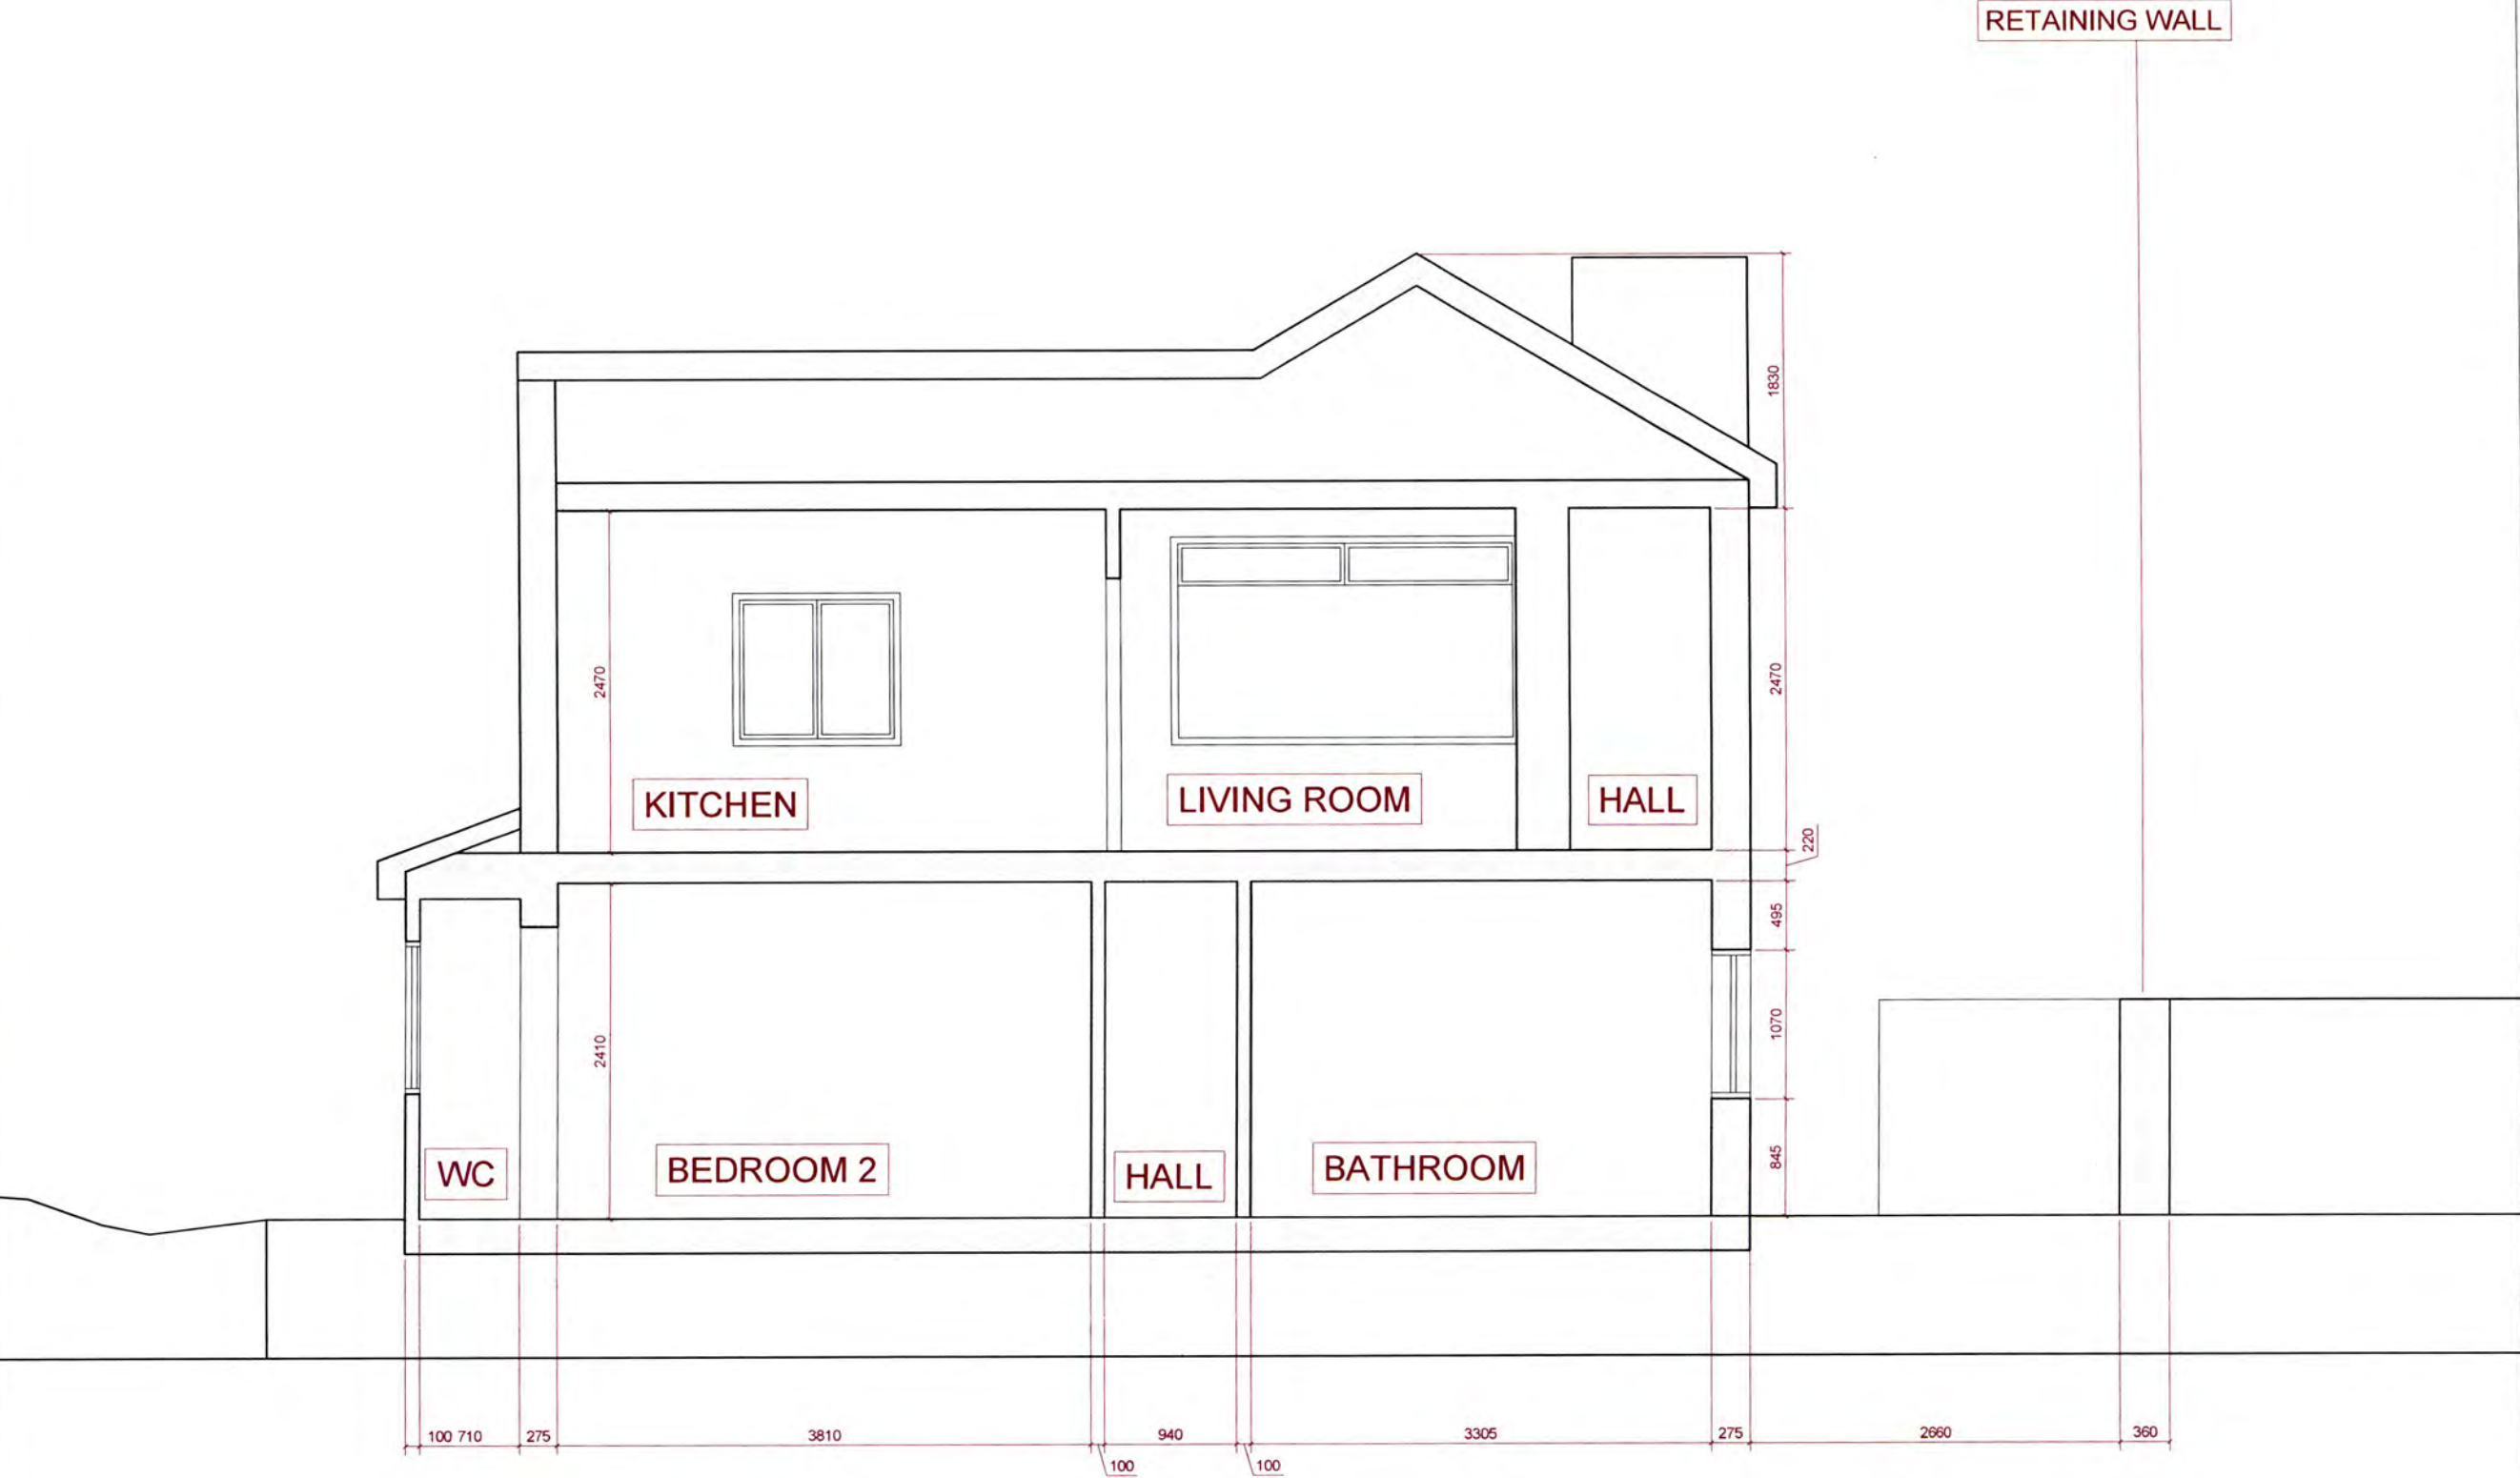

Disclaimer - Use of this Information

UNCONTROLLED INFORMATION

This dwg document is an uncontrolled version issued to enable the recipient to use this information at their own risk. The issuer accepts no liability for any such use. Design development is ongoing and so may affect this dwg uncontrolled information. For controlled information refer to formally issued drawings and documents. USE AT RECIPIENT'S RISK ONLY

It is the duty of the recipients of electronic transmissions to be aware that their system may be corrupted by the opening of any such transmission and that they be satisfied that measures are in place to prevent such an occurrence.


No responsibility or liability whatsoever will be accepted by ZAP if the recipient's computer system is corrupted by information transmitted from ZAP computers and/or for any delays or other losses arising out of or caused by transmission.

Viruses. Although we have taken steps to ensure that this e-mail and attachments are free from any virus, we advise that in keeping with good computing practice the recipient should ensure they are actually virus free.

Confidentiality. This information is intended for the named recipients only and may be confidential. If it has come to you in error you must take no action based on the contents, nor must you copy or show them to anyone, please notify ZAP and highlight the error.

Please note that we work natively in AutoCAD which produces dwg format drawings and we are aware that line styles do not convert correctly between dwg and dgn formats. We therefore cannot guarantee the completeness or accuracy of the information in the issued dwgs files and therefore the issued pdfs should always be used as a reference for the validity and accuracy of this information.

The contents of these drawings have been prepared solely for their use on this project and no other person or organisation should place reliance upon this information.

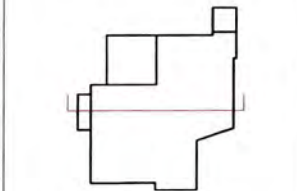


EXISTING



PLANNING

Work Package	Cost Check	Info/Briefing	Tender	Contract	Construction	Date	Revision	Description	Drawn by	Date	Ref.	Revision	Drawn by	Project	HILLCREST			Project Code	Drawing Number	Rev.
						14.01.2022	A	Existing section						Subject	EXISTING SECTION HILLCREST, LOWER KINDELTOWN, IRELAND			2203	351	B
						18.01.2022	B	Changes made accordingly to client's comments on 18.01.2022												

EXISTING SECTION BB

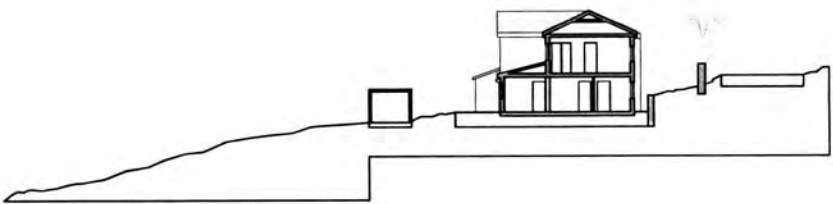

EXISTING KEY SECTION BB 1:500

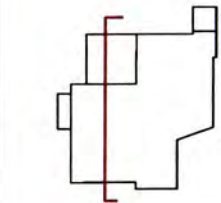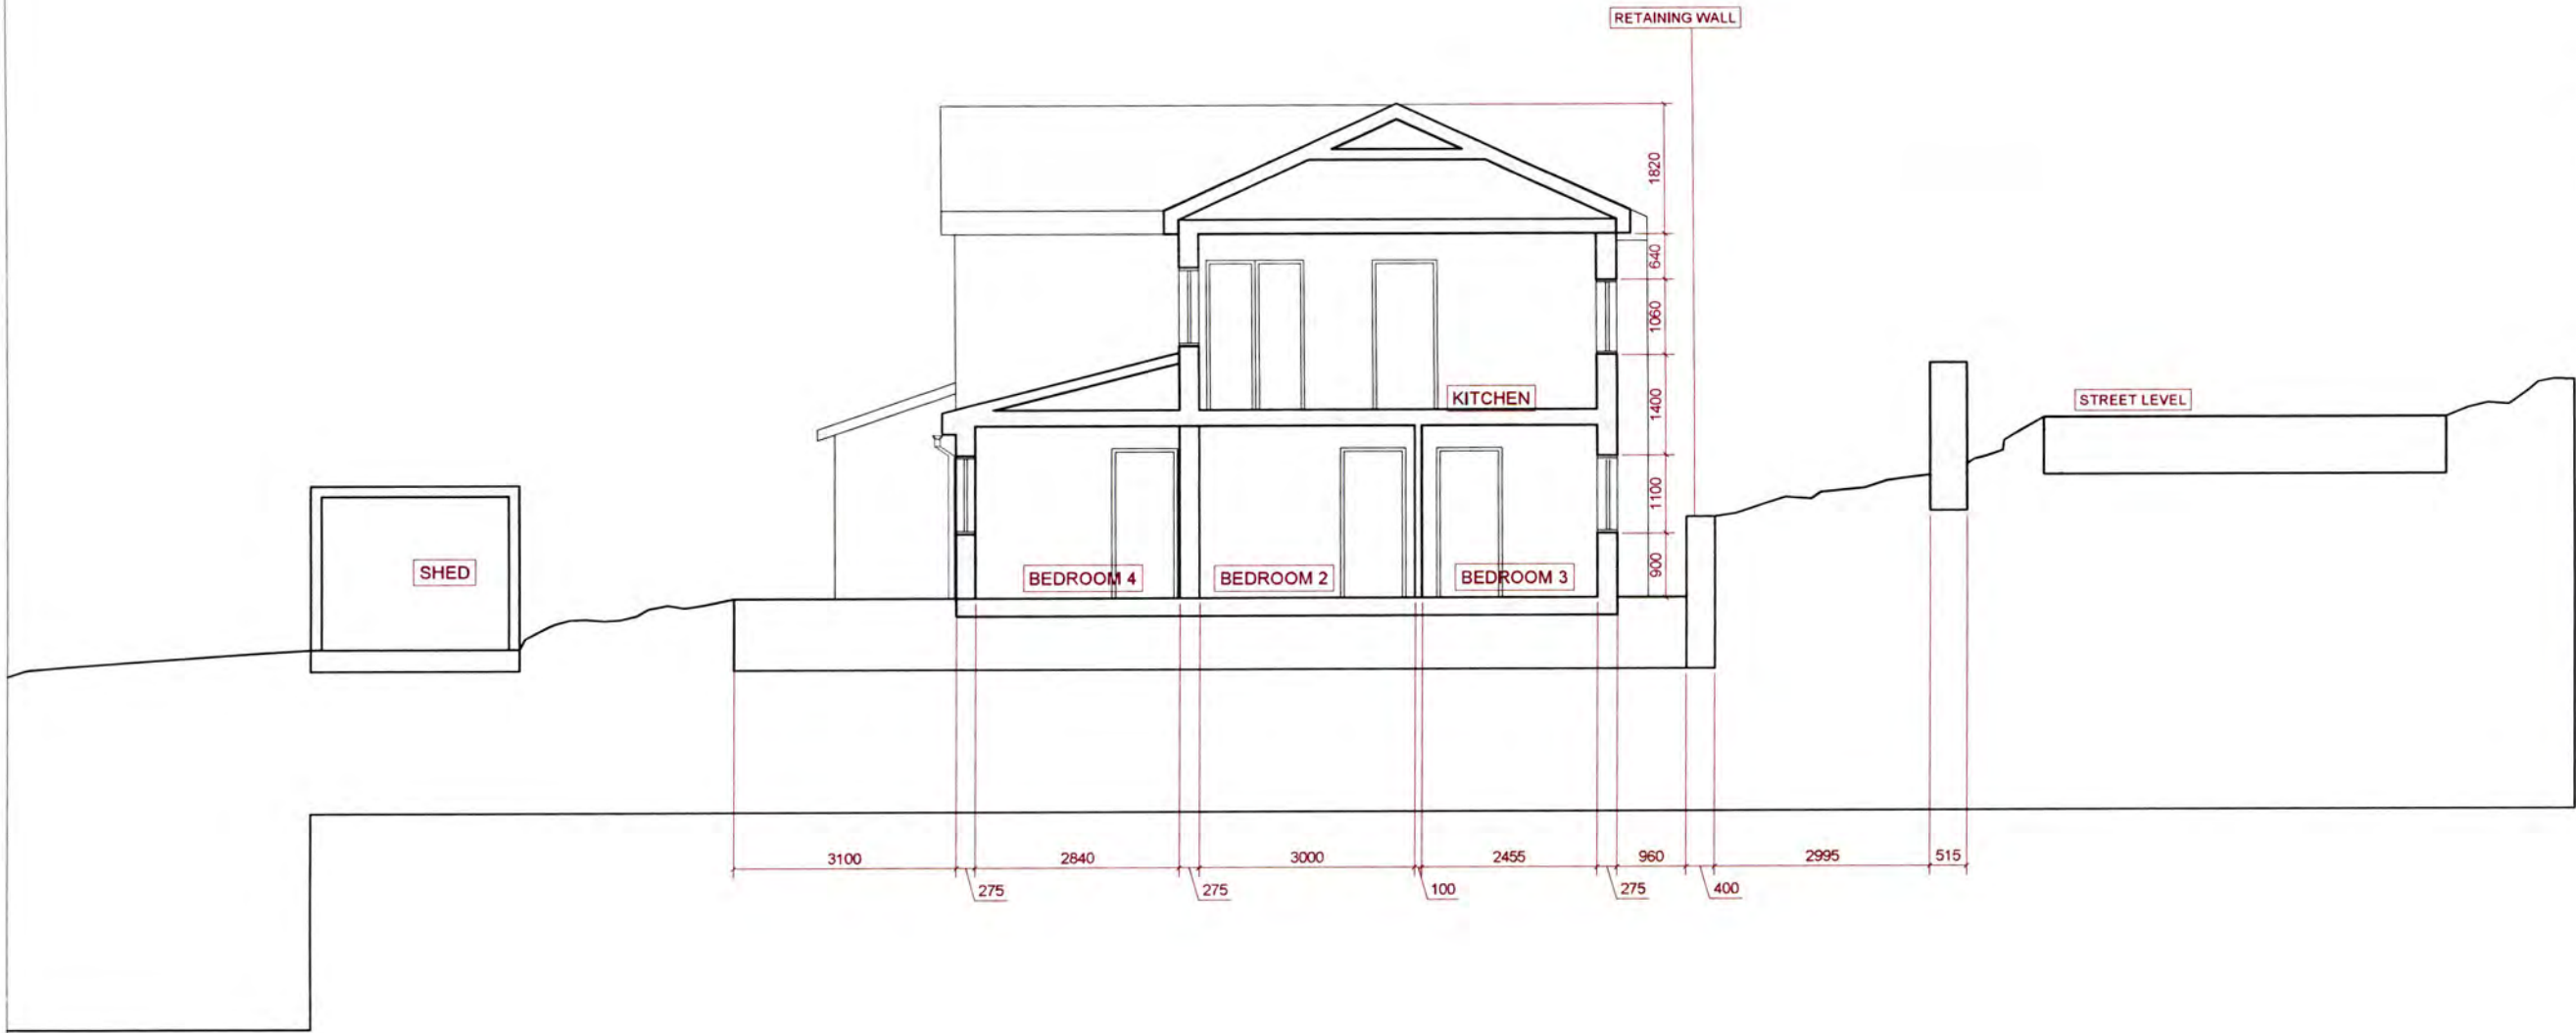

EXISTING

**PLANNING**

Work Package	Cost Check	Initial Briefing	Tender	Contract	Construction	Date	Revision	Description	Drawn by	Date	Ref.	Revision	Drawn by	Project	Subject	Architects	Project Code	Drawing Number	Rev.
-						14.01.2022	4	Existing section						HILLCREST	EXISTING SECTION	ZAP Architecture	2203	352	B
						18.01.2022	5	Changes made according to client's comments on 18.01.2022						HILLCREST, LOWER KINDELTOWN, IRELAND		305 High Street, London, E15 4QZ	18.01.2022	1:100 at A3	
																T: 020 37814999 E: info@zaparchitecture.com			

SITE MODEL



VISUAL 1- access from the road





VISUAL 2- garden view






• VISUAL 3- garden view





# AXONOMETRIC- SITE BOUNDARY

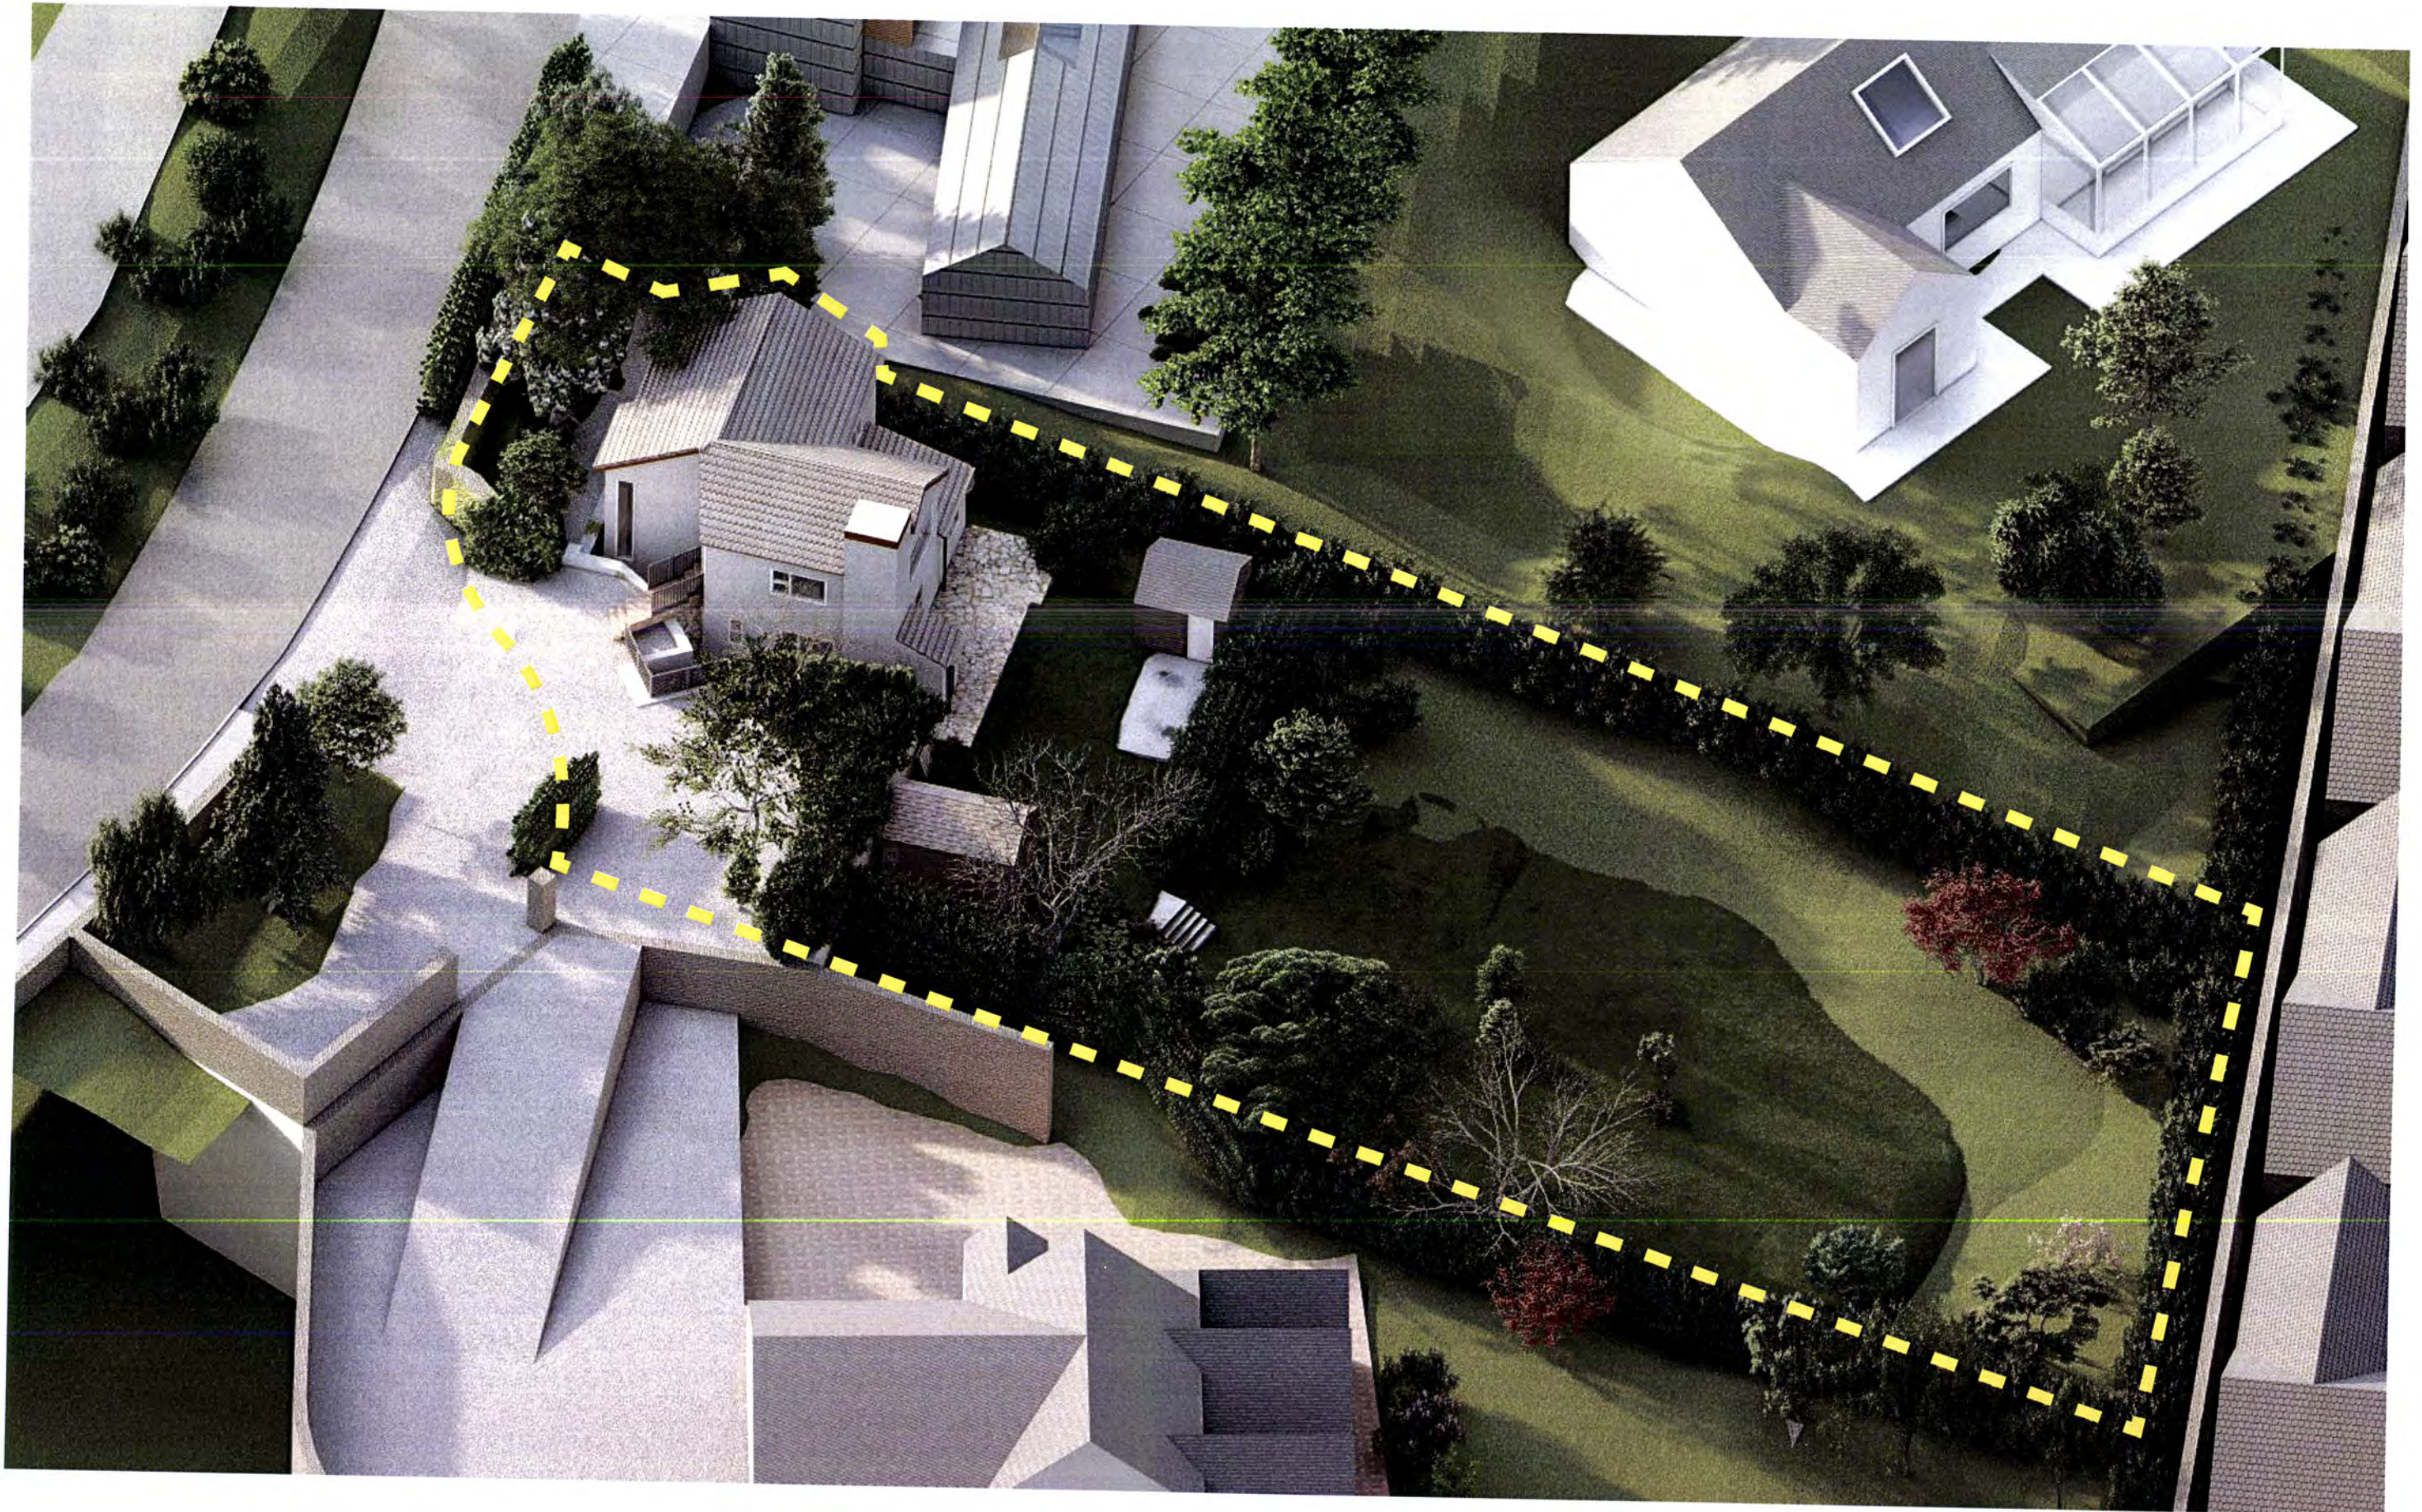




# AXONOMETRIC- CLOSE UP





HILLCREST  
A63 Y765, HILLCREST, LOWER KINDELSTOWN, IRELAND  
PERMITTED DEVELOPMENT  
PROPOSED DESIGN

7th April 2022

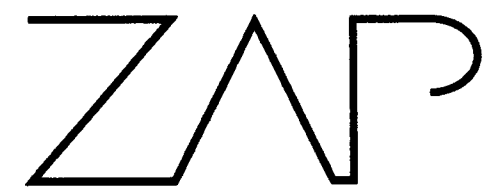




PROPOSED DRAWINGS



PROPOSED SITE PLAN

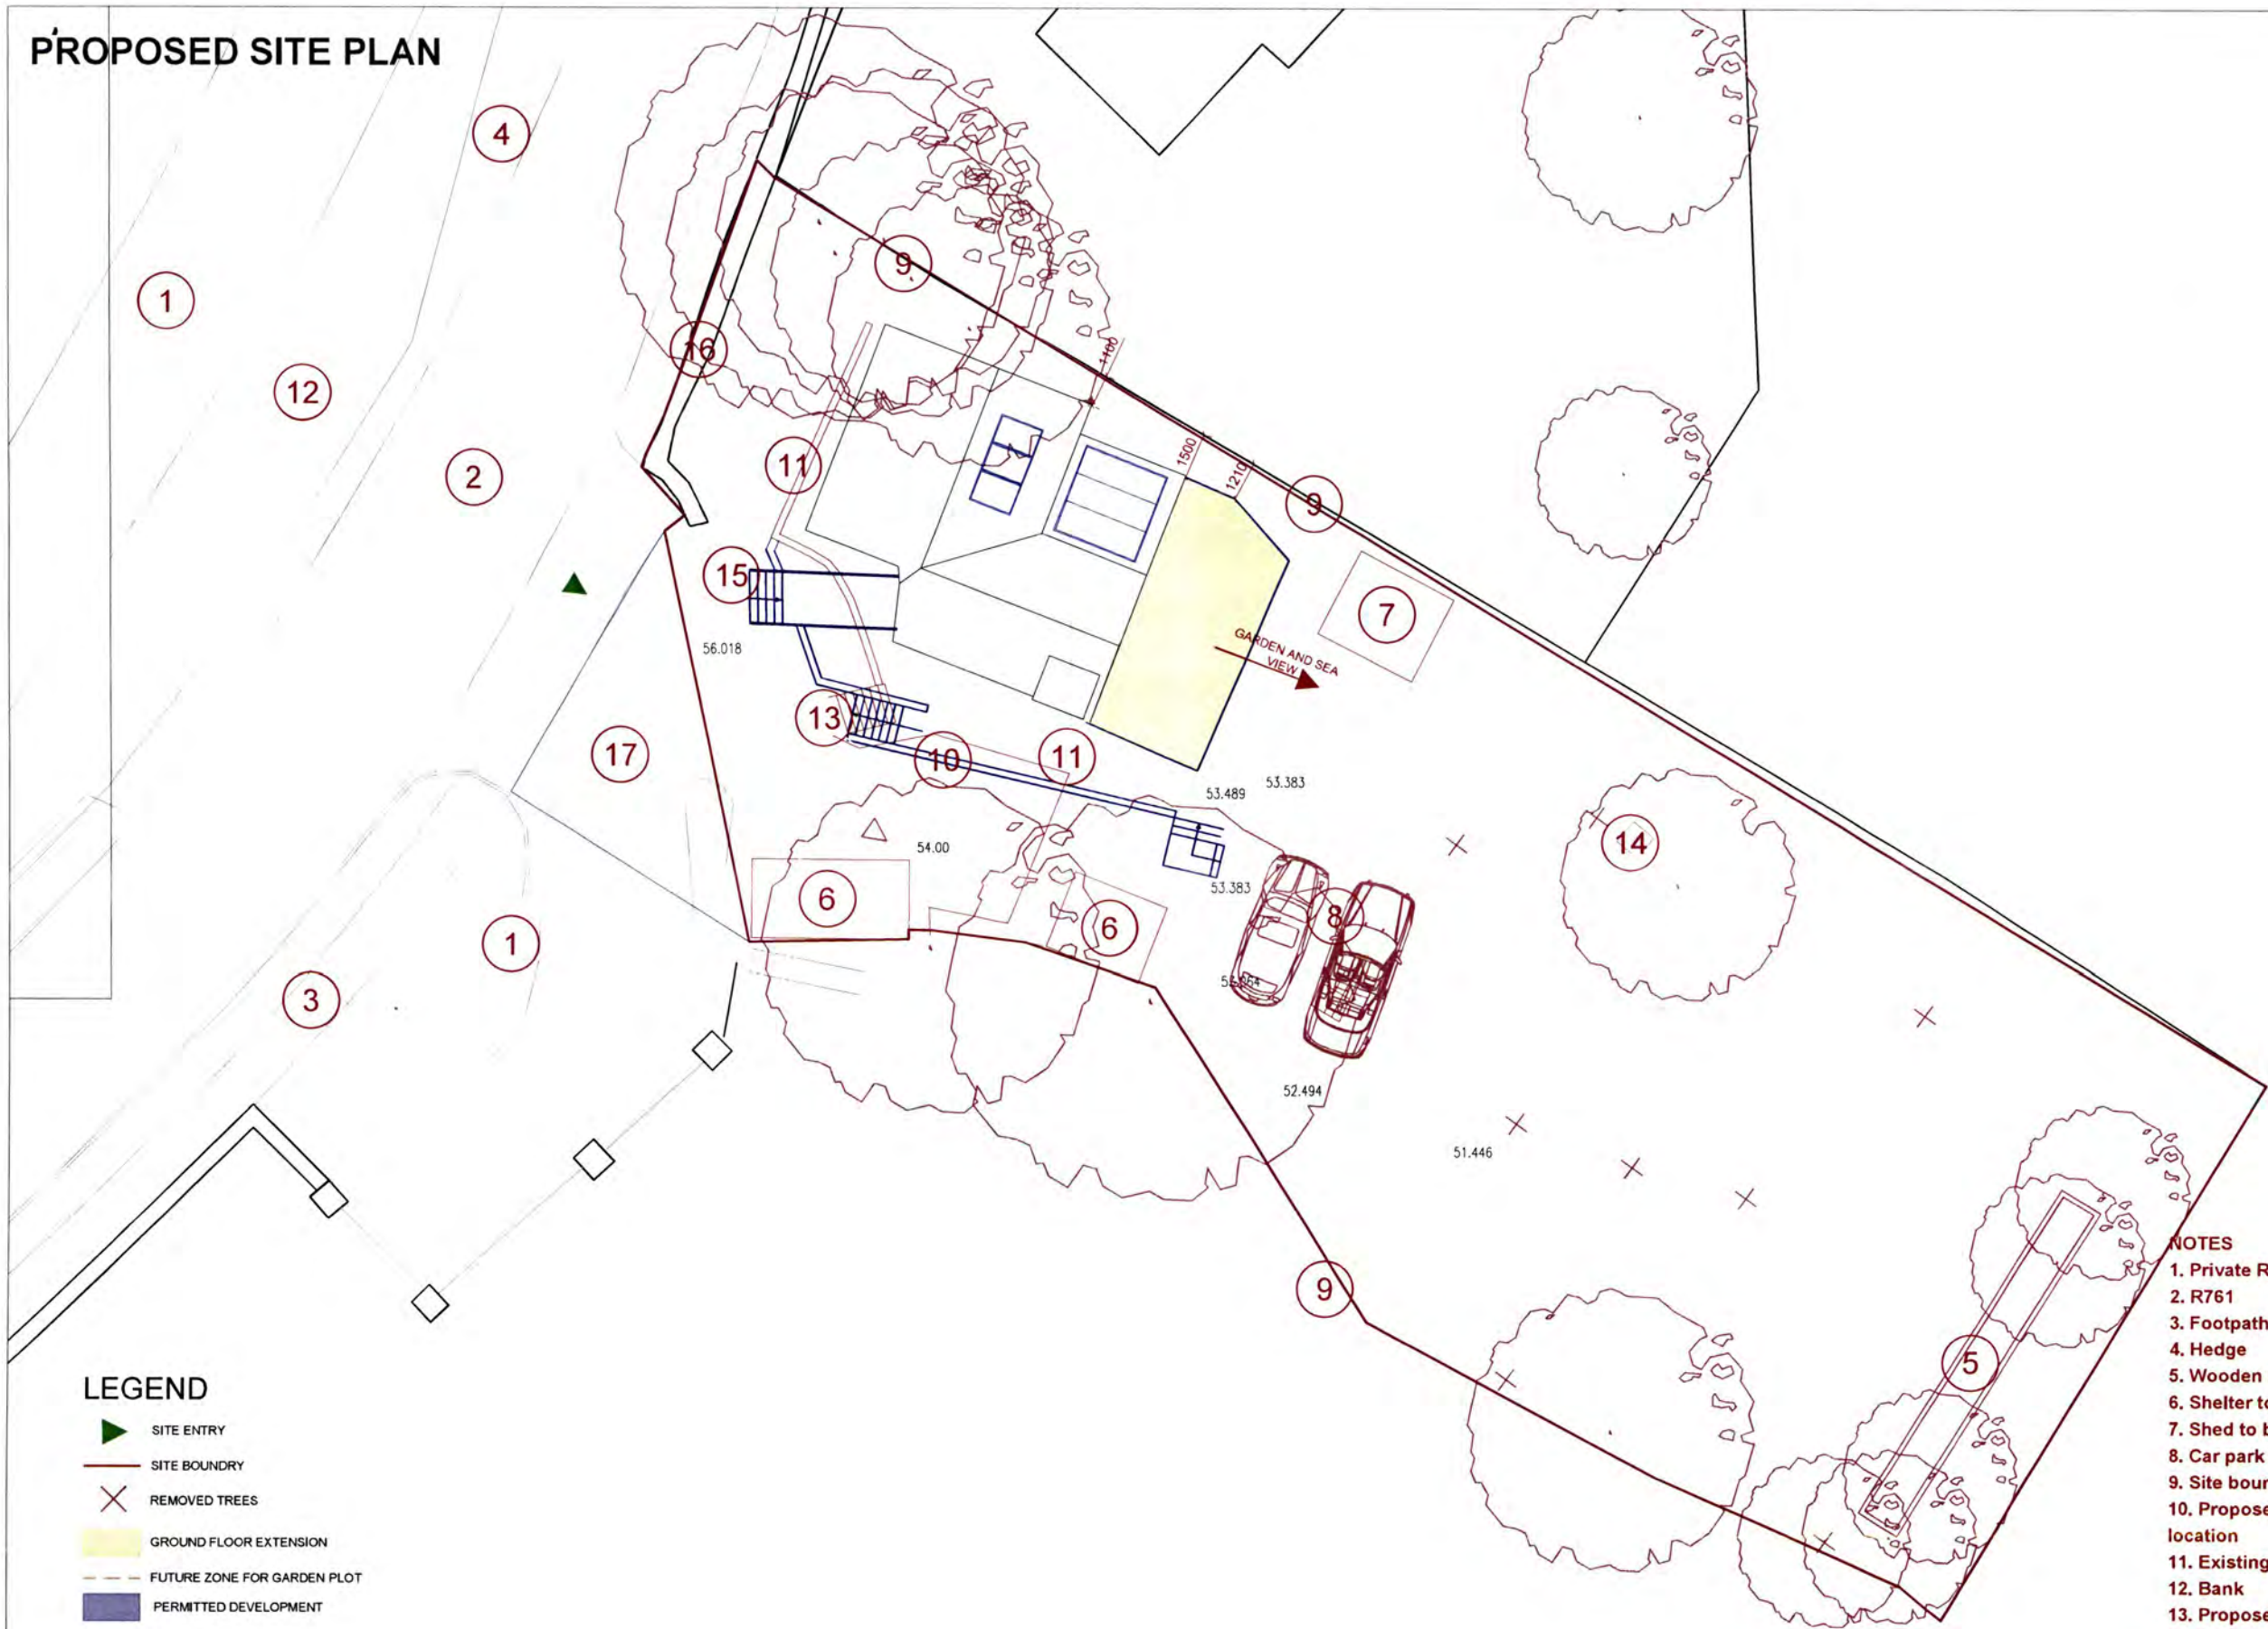


LEGEND

- SITE ENTRY
- SITE BOUNDARY
- REMOVED TREES
- GROUND FLOOR EXTENSION
- FUTURE ZONE FOR GARDEN PLOT
- PERMITTED DEVELOPMENT

NOTES

- Private Road
- R761
- Footpath
- Hedge
- Wooden Planting area
- Shelter to be removed
- Shed to be removed
- Car park
- Site boundary, iron fence
- Proposed retaining wall location
- Existing retaining wall
- Bank
- Proposed stairs
- Septic tank
- Proposed bridge
- New pedestrian walk
- Right of way

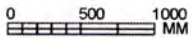

PROPOSED

PERMITTED DEVELOPMENT

Work Package	Cost Check	Info/Briefing	Tender	Contract	Construction	Date	Revision	Description	Drawn by	Date	Ref.	Revision	Drawn by	Project
						24.02.2022	A	Proposed Planning						HILLCREST
														SITE PLAN
														A63 Y765, HILLCREST
														LOWER KINDELSTOWN, IRELAND
														Architects
														ZAP Architecture
														365 High Street, London, E15 4QZ
														T: 020 37614995 E: info@zaparchitecture.com

Disclaimer - Use of this Information

UNCONTROLLED INFORMATION

This dwg document is an uncontrolled version issued to enable the recipient to use this information at their own risk. The user accepts no liability for any such use. Design development is ongoing and so may affect this dwg uncontrolled information. For controlled information refer to formally issued drawings and documents. USE AT RECIPIENT'S RISK ONLY.

It is the duty of the recipients of electronic transmissions to be aware that their system may be corrupted by the opening of any such transmission and that they be satisfied that measures are in place to prevent such an occurrence.

No responsibility or liability whatsoever will be accepted by ZAP if the recipient's computer system is corrupted by information transmitted from ZAP computers and/or for any delays or other losses arising out of or caused by transmission.

Viruses: Although we have taken steps to ensure that this e-mail and attachments are free from any virus, we advise that in keeping with good computing practice the recipient should ensure they are actually virus free.

Confidentiality: This information is intended for the named recipients only and may be confidential. If it has come to you in error you must take no action based on the contents, nor must you copy or show them to anyone, please notify ZAP and highlight the error.

Please note that we work natively in AutoCAD which produces dwg format drawings and we are aware that line styles do not convert correctly between dwg and dgn formats. We therefore cannot guarantee the completeness or accuracy of the information in the issued dwg files and therefore the issued pdfs should always be used as a reference for the validity and accuracy of this information.

The contents of these drawings have been prepared solely for their use on this project and no other person or organisation should place reliance upon this information.

ZAP

Project Code	Drawing Number	Rev
2203	154	A
Date	24.02.2022	Scale 1:50 at A3



PROPOSED GROUND FLOOR CONTEXT PLAN

STEPS DOWN TO THE GARDEN

CAR PARK


NEW STEPS

NEW STAIRCASE TO THE GROUND FLOOR

NEW BRIDGE (access on the FF level)

Disclaimer - Use of this Information  
UNCONTROLLED INFORMATION  
This dwg document is an uncontrolled version issued to enable the recipient to use this information at their own risk. The issuer accepts no liability for any such use. Design development is ongoing and so may affect this dwg uncontrolled information. For controlled information refer to formally issued drawings and documents. USE AT RECIPIENT'S RISK ONLY  
It is the duty of the recipients of electronic transmissions to be aware that their system may be corrupted by the opening of any such transmission and that they be satisfied that measures are in place to prevent such an occurrence.  
No responsibility or liability whatsoever will be accepted by ZAP if the recipient's computer system is corrupted by information transmitted from ZAP computers and/or for any delays or other losses arising out of or caused by transmission.  
Viruses. Although we have taken steps to ensure that this e-mail and attachments are free from any virus, we advise that in keeping with good computing practice the recipient should ensure they are actually virus-free.  
Confidentiality. This information is intended for the named recipients only and may be confidential. If it has come to you in error you must take no action based on the contents, nor must you copy or show them to anyone, please notify ZAP and highlight the error.  
Please note that we work natively in AutoCAD which produces dwg format drawings and we are aware that line styles do not convert correctly between dwg and dgn formats. We therefore cannot guarantee the completeness or accuracy of the information in the issued dwg files and therefore the issued pdfs should always be used as a reference for the validity and accuracy of this information.  
The contents of these drawings have been prepared solely for their use on this project and no other person or organisation should place reliance upon this information.

ZAP

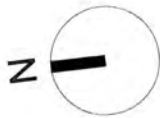


PROPOSED

PERMITTED DEVELOPMENT

Work Package	Cost Check	Info/Briefing	Tender	Contract	Construction	Date	Revision	Description	Drawn By	Date	Ref.	Revision	Drawn By	Project	Project Code	Drawing Number	Rev.
						24.01.2022	A	Proposed Planning						HILLCREST			
						02.02.2022	B	Amending comments and changes made by client on 01.02.2022						GROUND FLOOR PLAN	2203	155	C
						17.02.2022	C	Amending comments and changes made by client on 14.02.2022						A63 Y765, HILLCREST			
														LOWER KINDELSTOWN, IRELAND			
														ZAP Architecture			
														365 High Street, London, E15 4QZ			
														T: 020 37614990 E: info@zaparchitecture.com			
															Date	17.02.2022	Scale 1:100 at A3



# PROPOSED GROUND FLOOR PLAN

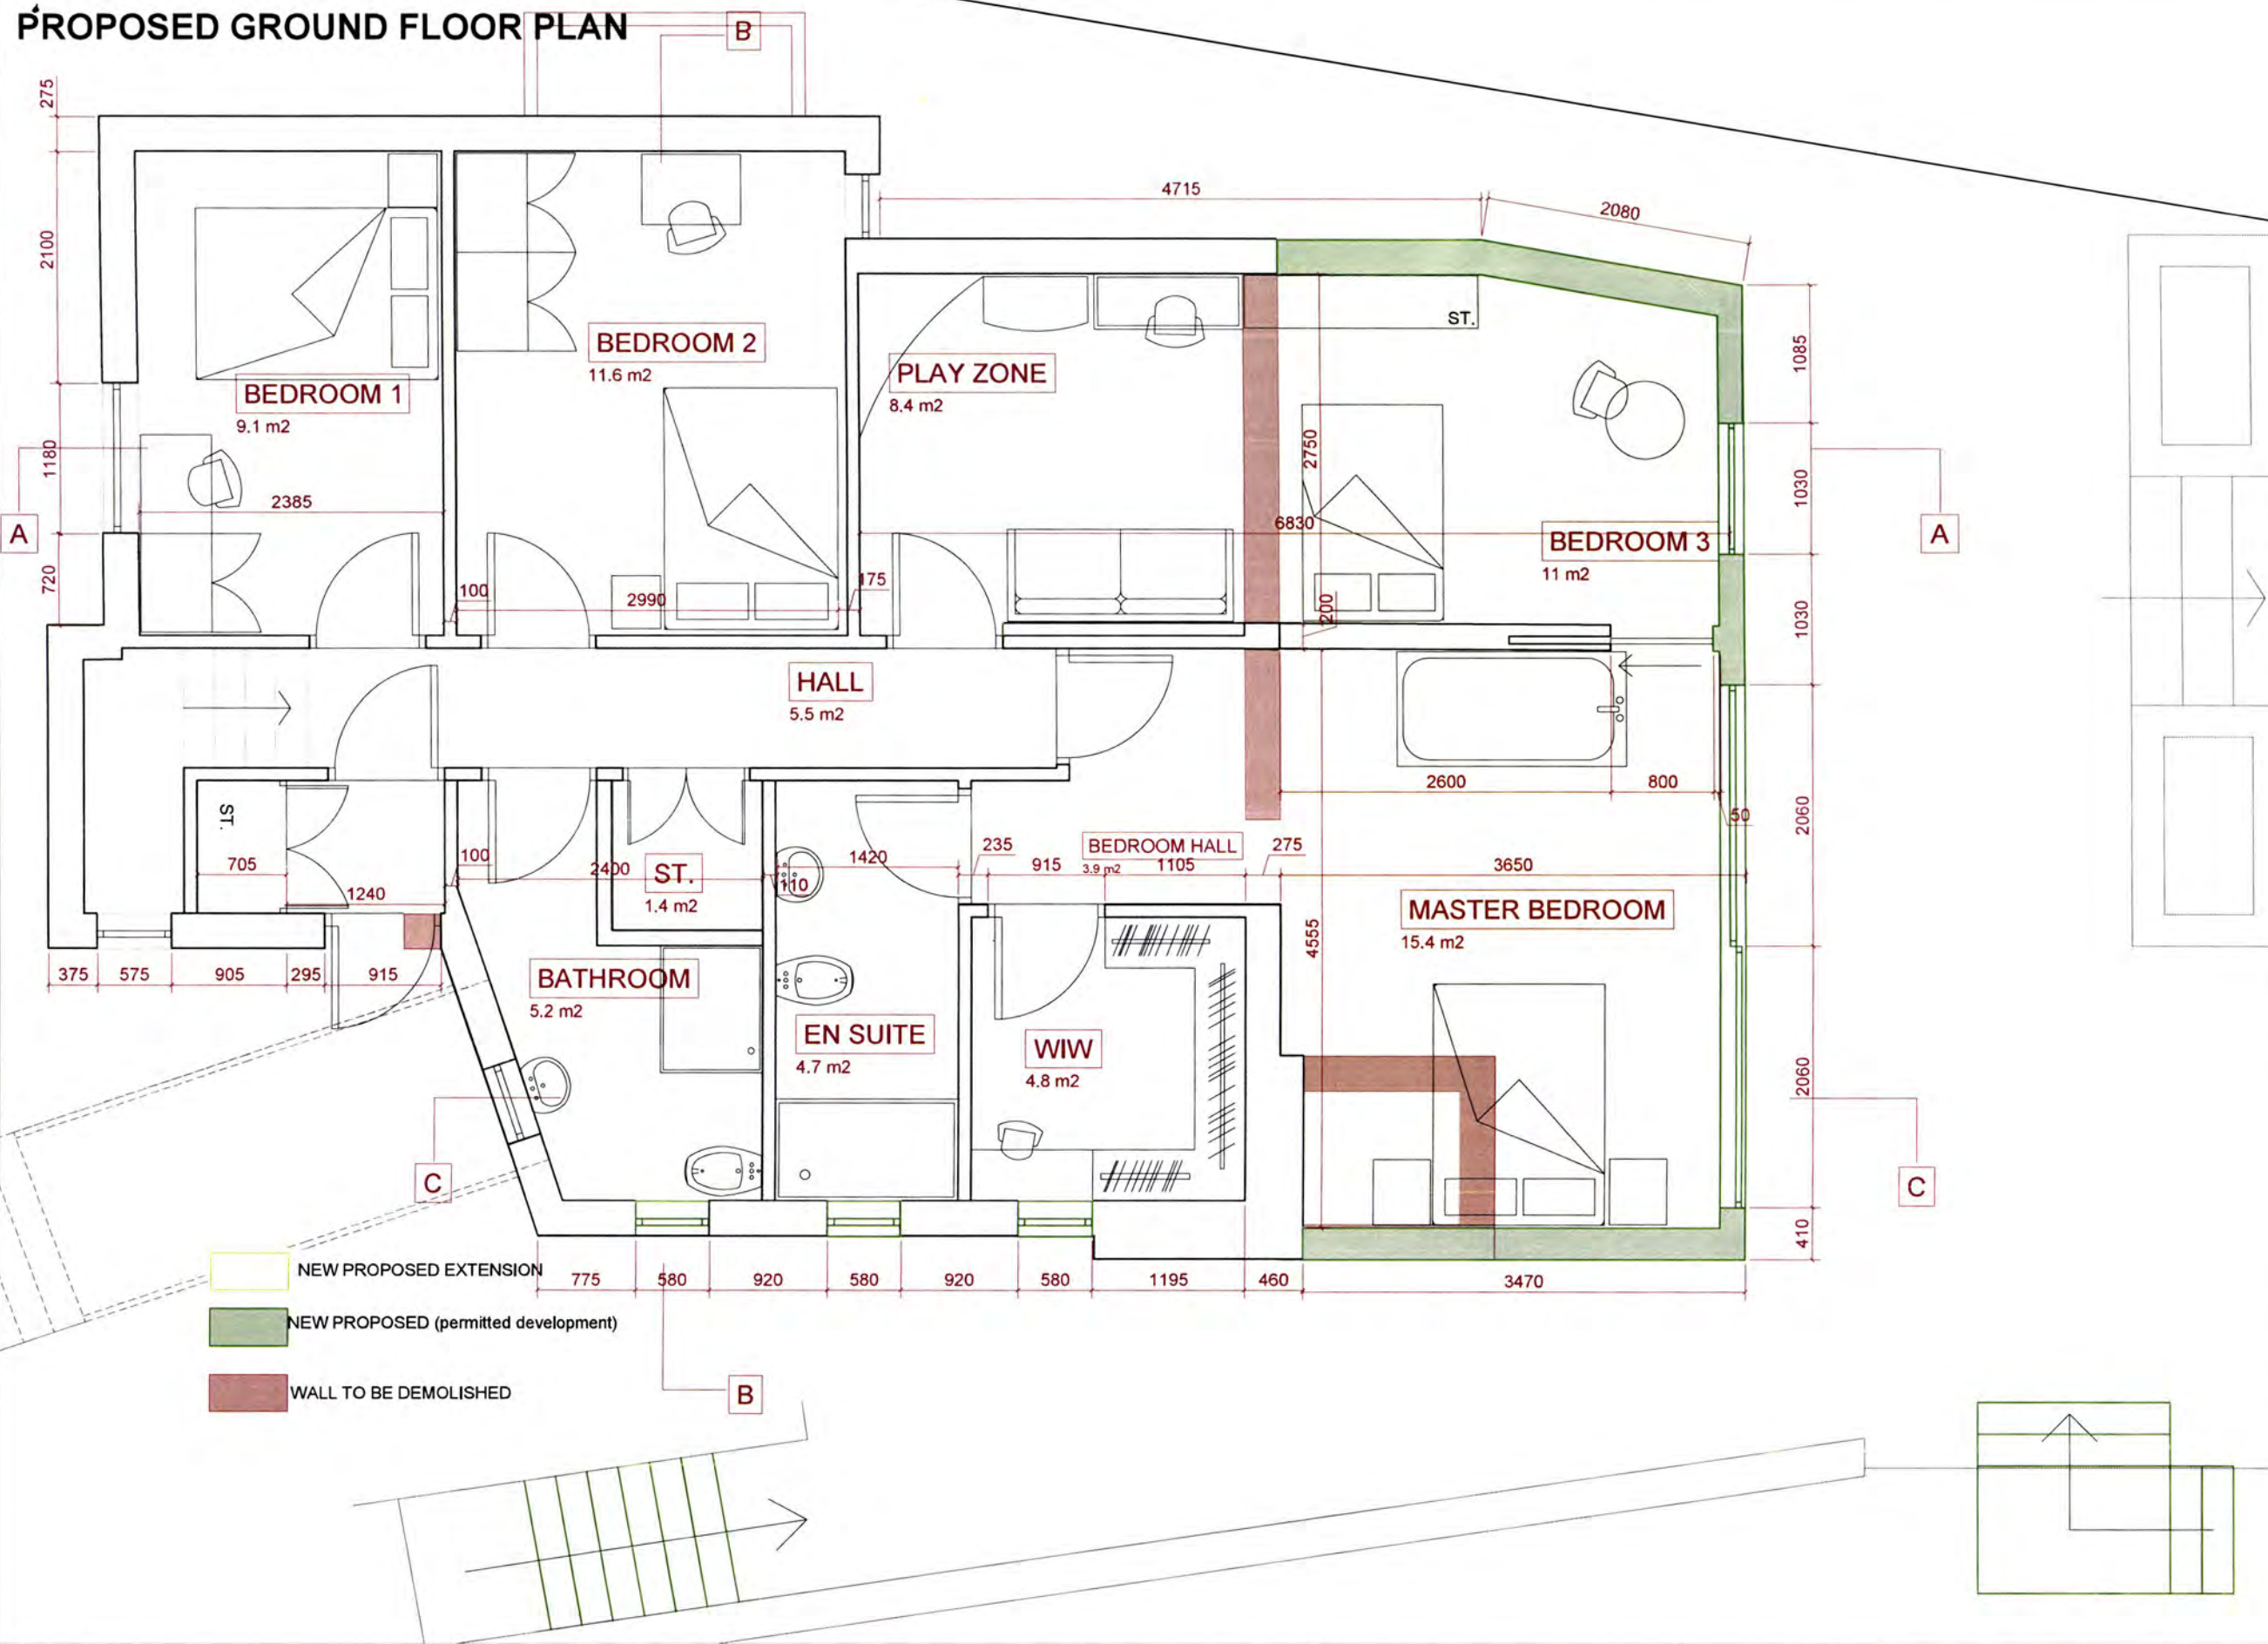

**Disclaimer - Use of this Information**  
**UNCONTROLLED INFORMATION**

This dwg document is an uncontrolled version issued to enable the recipient to use this information at their own risk. The issuer accepts no liability for any such use. Design development is ongoing and so may affect this dwg uncontrolled information. For controlled information refer to formally issued drawings and documents. **USE AT RECIPIENT'S RISK ONLY.**

It is the duty of the recipients of electronic transmissions to be aware that their system may be corrupted by the opening of any such transmission and that they be satisfied that measures are in place to prevent such an occurrence.

No responsibility or liability whatsoever will be accepted by ZAP if the recipient's computer system is corrupted by information transmitted from ZAP computers and/or for any delays or other losses arising out of or caused by transmission.

Viruses: Although we have taken steps to ensure that this e-mail and attachments are free from any virus, we advise that in keeping with good computing practice the recipient should ensure they are actually virus free.

Confidentiality: This information is intended for the named recipients only and may be confidential. If it has come to you in error you must take no action based on the contents, nor must you copy or show them to anyone, please notify ZAP and highlight the error.

Please note that we work natively in AutoCAD which produces dwg format drawings and we are aware that line styles do not convert correctly between dwg and dgn formats. We therefore cannot guarantee the completeness or accuracy of the information in the issued dwg files and therefore the issued pdfs should always be used as a reference for the validity and accuracy of this information.

The contents of these drawings have been prepared solely for their use on this project and no other person or organisation should place reliance upon this information.



**N**

0 500 1000  
mm


**PROPOSED**

**PERMITTED DEVELOPMENT**

Work Package	Cost Check	Info/Briefing	Tender	Contract	Construction	Date	Revision	Description	Drawn by	Date	Ref.	Revision	Drawn by	Project	Project Code	Drawing Number	Rev.
						24.01.2022	A	Proposed Planning						<b>HILLCREST</b>			
						02.02.2022	B	Amending comments and changes made by client on 01.02.2022						<b>GROUND FLOOR PLAN</b>	<b>2203</b>	<b>156</b>	<b>C</b>
						17.02.2022	C	Amending comments and changes made by client on 14.02.2022						<b>A63 Y765, HILLCREST</b>			
														<b>LOWER KINDELSTOWN, IRELAND</b>			
														<b>ZAP Architecture</b>			
														<b>345 High Street, London, E15 4QZ</b>			
														<b>T: 020 3761 4696 E: info@zaparchitecture.com</b>			
															Date	17.02.2022	Scale 1:50 at A3




PROPOSED FIRST FLOOR PLAN

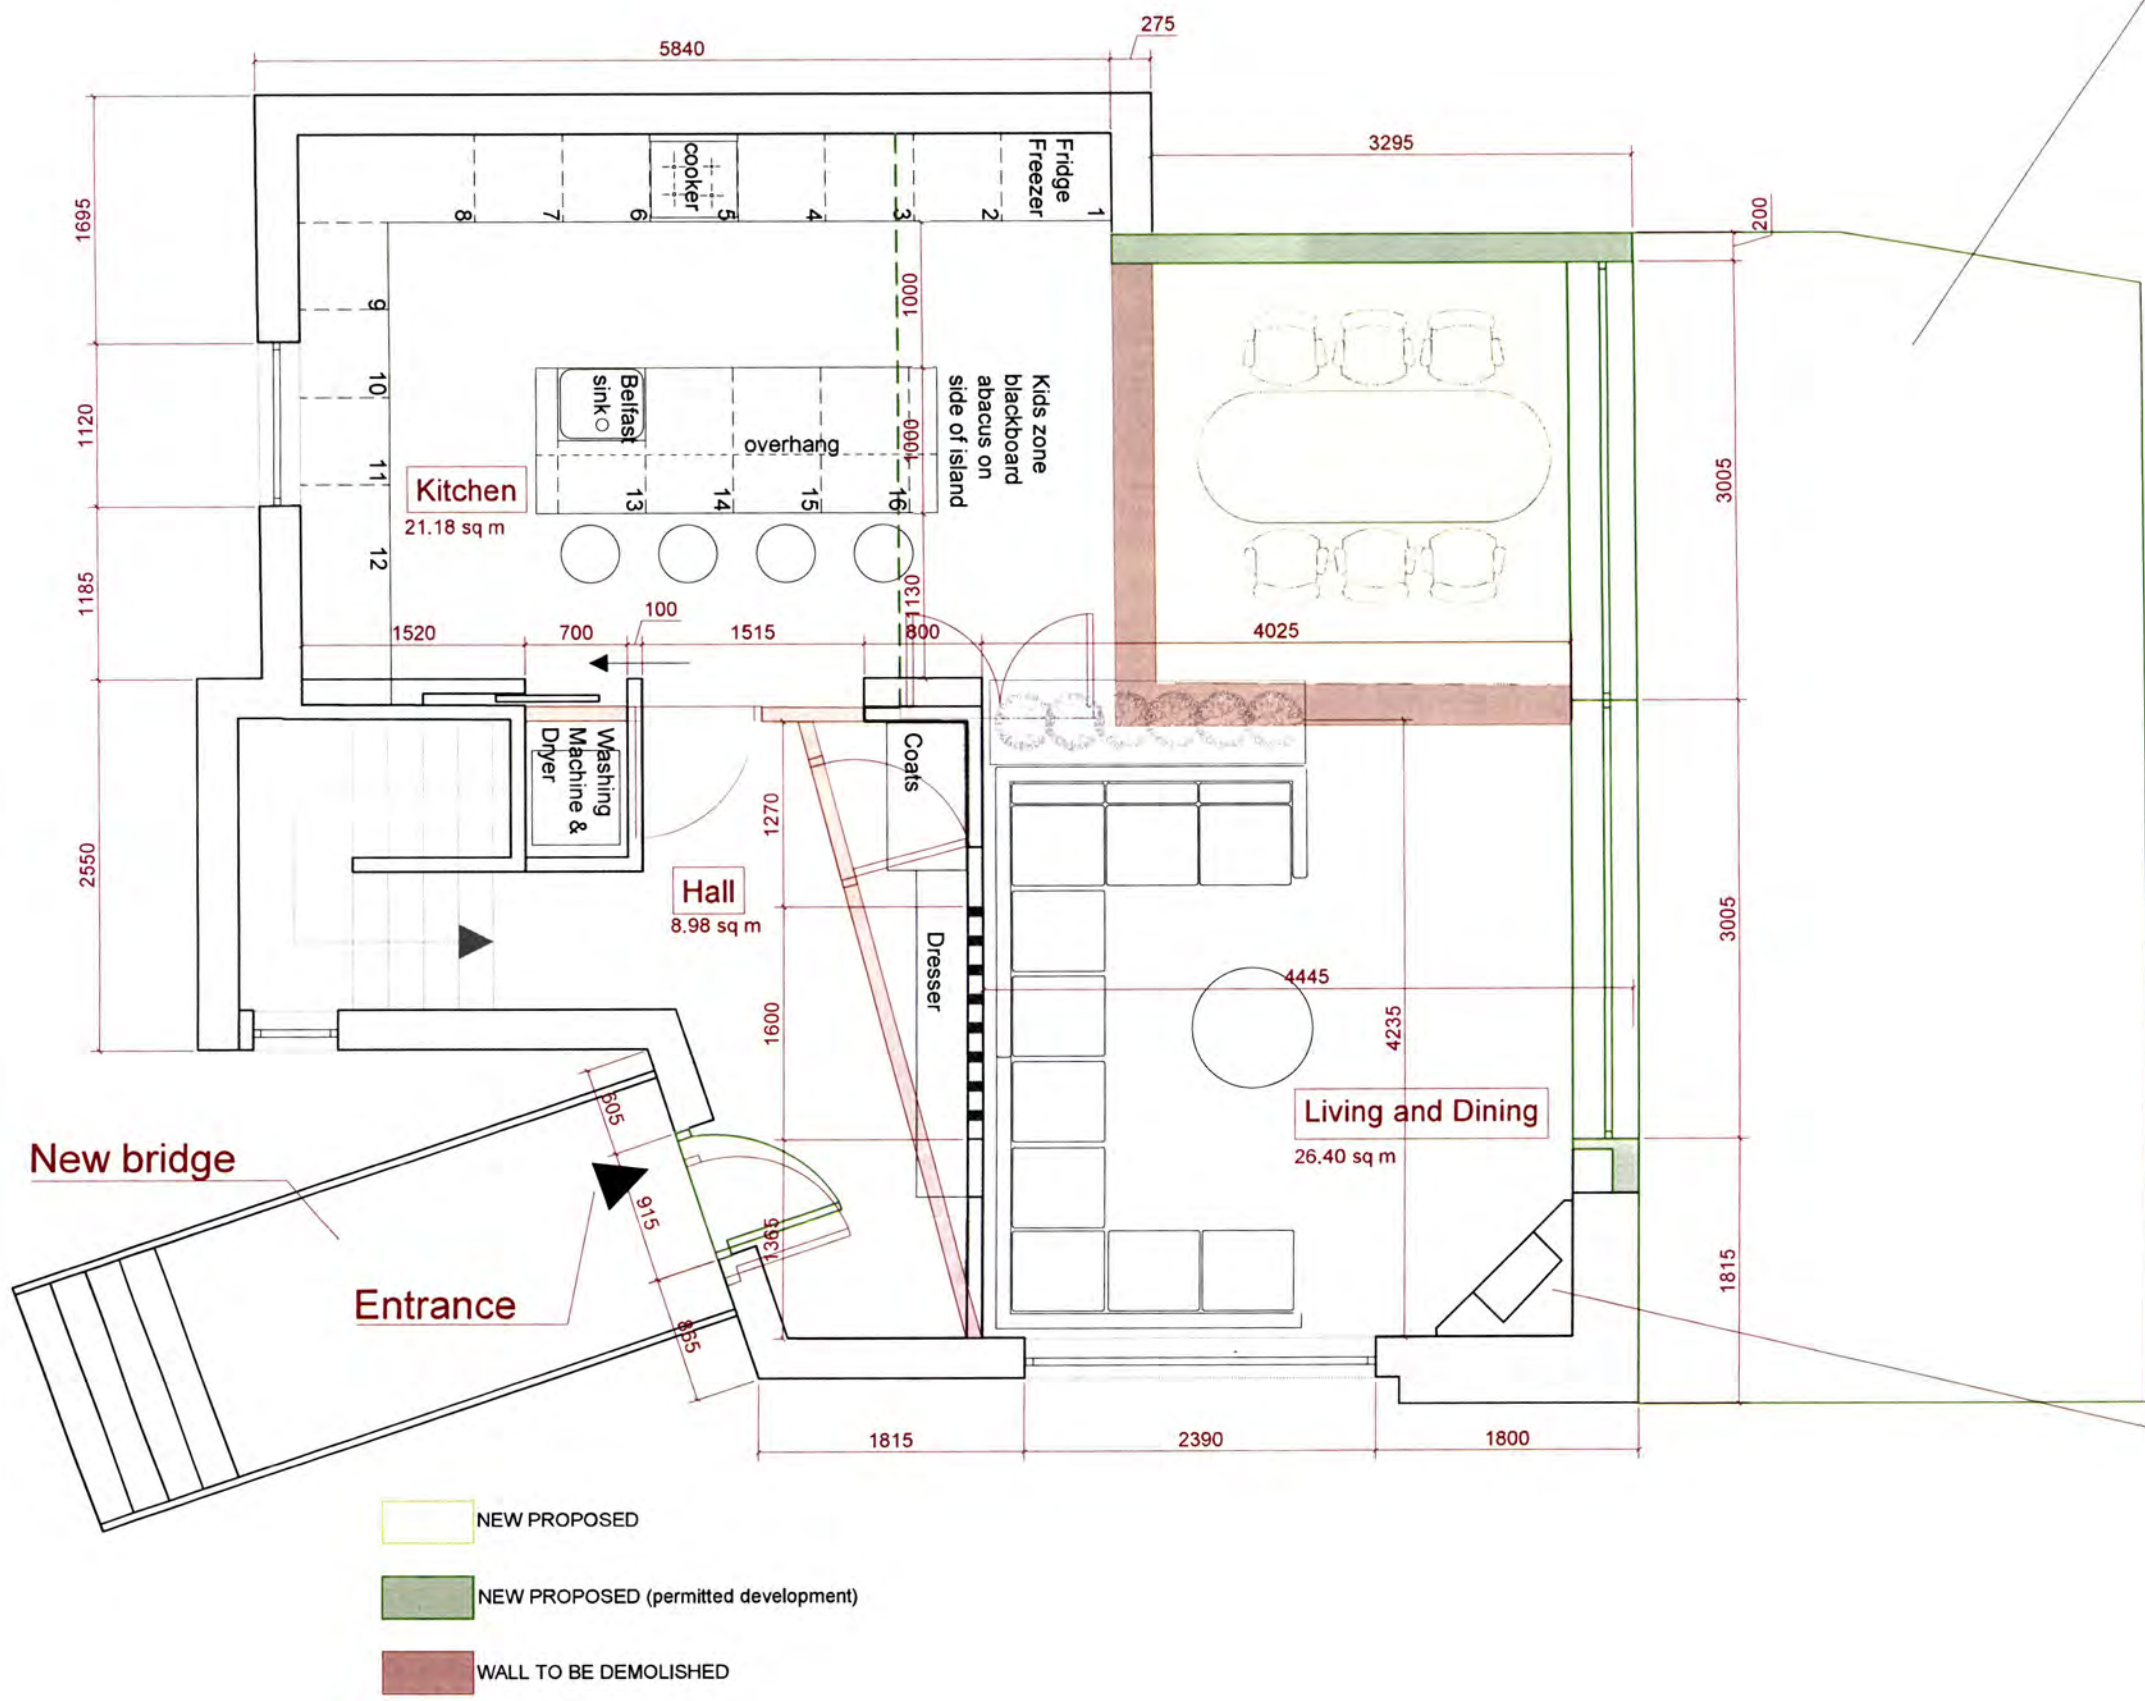

Extension underneath

Fire place  
and TV above

**Disclaimer - Use of this information**  
**UNCONTROLLED INFORMATION**  
This dwg document is an uncontrolled version issued to enable the recipient to use this information at their own risk. The issuer accepts no liability for any such use. Design development is ongoing and so may affect this dwg uncontrolled information. For controlled information refer to formally issued drawings and documents.  
**USE AT RECIPIENT'S RISK ONLY**  
It is the duty of the recipients of electronic transmissions to be aware that their system may be corrupted by the opening of any such transmission and that they be satisfied that measures are in place to prevent such an occurrence.  
No responsibility or liability whatsoever will be accepted by ZAP if the recipient's computer system is corrupted by information transmitted from ZAP computers and/or for any delays or other losses arising out of or caused by transmission.  
Viruses: Although we have taken steps to ensure that this e-mail and attachments are free from any virus, we advise that in keeping with good computing practice the recipient should ensure they are actually virus free.  
Confidentiality: This information is intended for the named recipients only and may be confidential. If it has come to you in error you must take no action based on the contents, nor must you copy or show them to anyone, please notify ZAP and highlight the error.  
Please note that we work natively in AutoCAD which produces dwg format drawings and we are aware that line styles do not convert correctly between dwg and dgn formats. We therefore cannot guarantee the completeness or accuracy of the information in the issued dwg files and therefore the issued pdfs should always be used as a reference for the validity and accuracy of this information.  
The contents of these drawings have been prepared solely for their use on this project and no other person or organisation should place reliance upon this information.

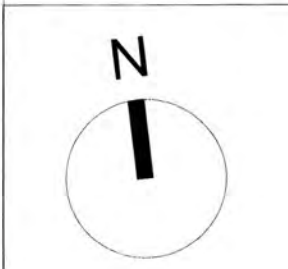


**PROPOSED**  
**PERMITTED DEVELOPMENT**

Work Package	Cost Check	Info/Briefing	Tender	Contract	Construction	Date	Revision	Description	Drawn by	Date	Ref.	Revision	Drawn by	Project	Subject	Architects	Project Code	Drawing Number	Rev.			
						24.01.2022	A	Proposed Planning						HILLCREST	FIRST FLOOR PLAN	ZAP Architecture	2203	157	C			
						02.02.2022	B	Amending comments and changes made by client on 01.02.2022						A63 Y765, HILLCREST LOWER KINDELSTOWN, IRELAND	365 High Street, London, E15 4QZ T: 020 31514966 E: info@zaparchitecture.com							
																	Date	17.02.2022	Scale	1:50	at	A3



PROPOSED ROOF PLAN

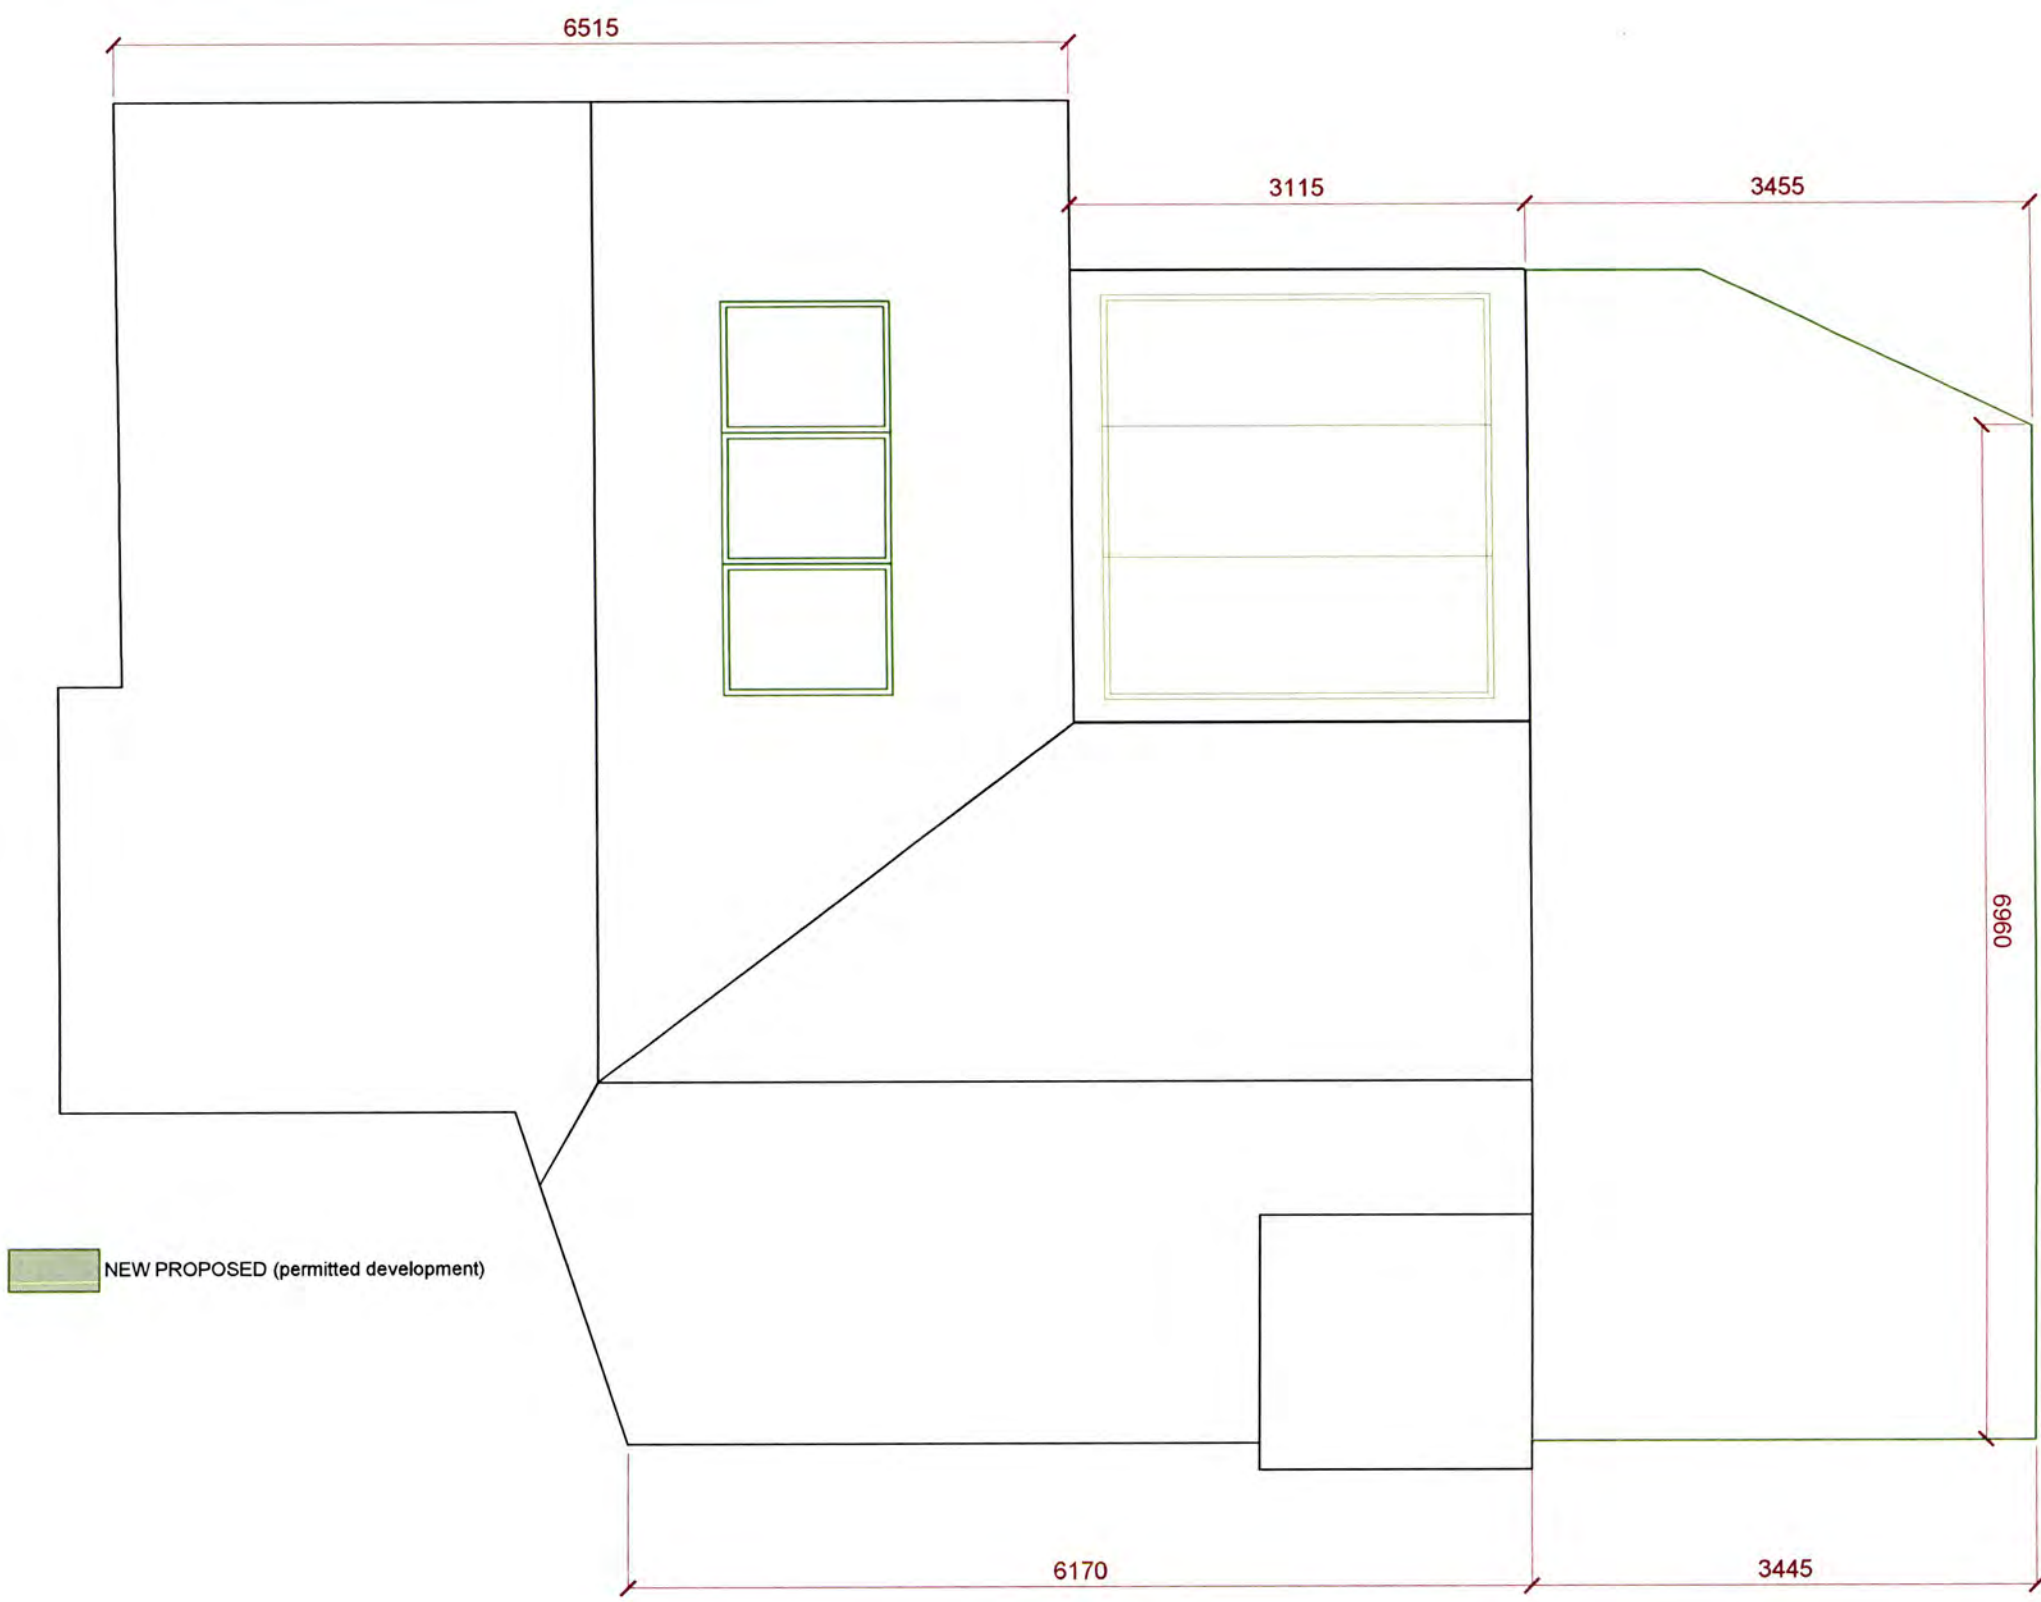

Disclaimer - Use of this information  
UNCONTROLLED INFORMATION

This dwg document is an uncontrolled version issued to enable the recipient to use this information at their own risk. The issuer accepts no liability for any such use. Design development is ongoing and so may affect this dwg uncontrolled information. For controlled information refer to formally issued drawings and documents. USE AT RECIPIENT'S RISK ONLY.

It is the duty of the recipients of electronic transmissions to be aware that their system may be corrupted by the opening of any such transmission and that they be satisfied that measures are in place to prevent such an occurrence.


No responsibility or liability whatsoever will be accepted by ZAP if the recipient's computer system is corrupted by information transmitted from ZAP computers and/or for any delays or other losses arising out of or caused by transmission.

Viruses. Although we have taken steps to ensure that this e-mail and attachments are free from any virus, we advise that in keeping with good computing practice the recipient should ensure they are actually virus free.

Confidentiality. This information is intended for the named recipients only and may be confidential. If it has come to you in error you must take no action based on the contents, nor must you copy or show them to anyone, please notify ZAP and highlight the error.

Please note that we work natively in AutoCAD which produces dwg format drawings and we are aware that line styles do not convert correctly between dwg and dgn formats. We therefore cannot guarantee the completeness or accuracy of the information in the issued dwg files and therefore the issued pdfs should always be used as a reference for the validity and accuracy of this information.

The contents of these drawings have been prepared solely for their use on this project and no other person or organisation should place reliance upon this information.

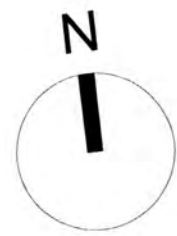


PROPOSED  
PERMITTED  
DEVELOPMENT

Work Package	Cost Check	Info/Briefing	Tender	Contract	Construction	Date	Revision	Description	Drawn by	Date	Ref	Revision	Drawn by	Project	Project Code	Drawing Number	Rev.
						24.02.2022	A	proposed Roof plan						HILLCREST	2203	158	B
														ROOF PLAN			
														A63 Y765, HILLCREST			
														LOWER KINDELSTOWN, IRELAND			
														Architects			
														ZAP Architecture			
														369 High Street, London, E15 4QZ			
														T: 020 3761 4966 E: info@zaparchitecture.com			
															Date	24.02.2022	Scale 1:50 at A3



PROPOSED ELEVATION 01

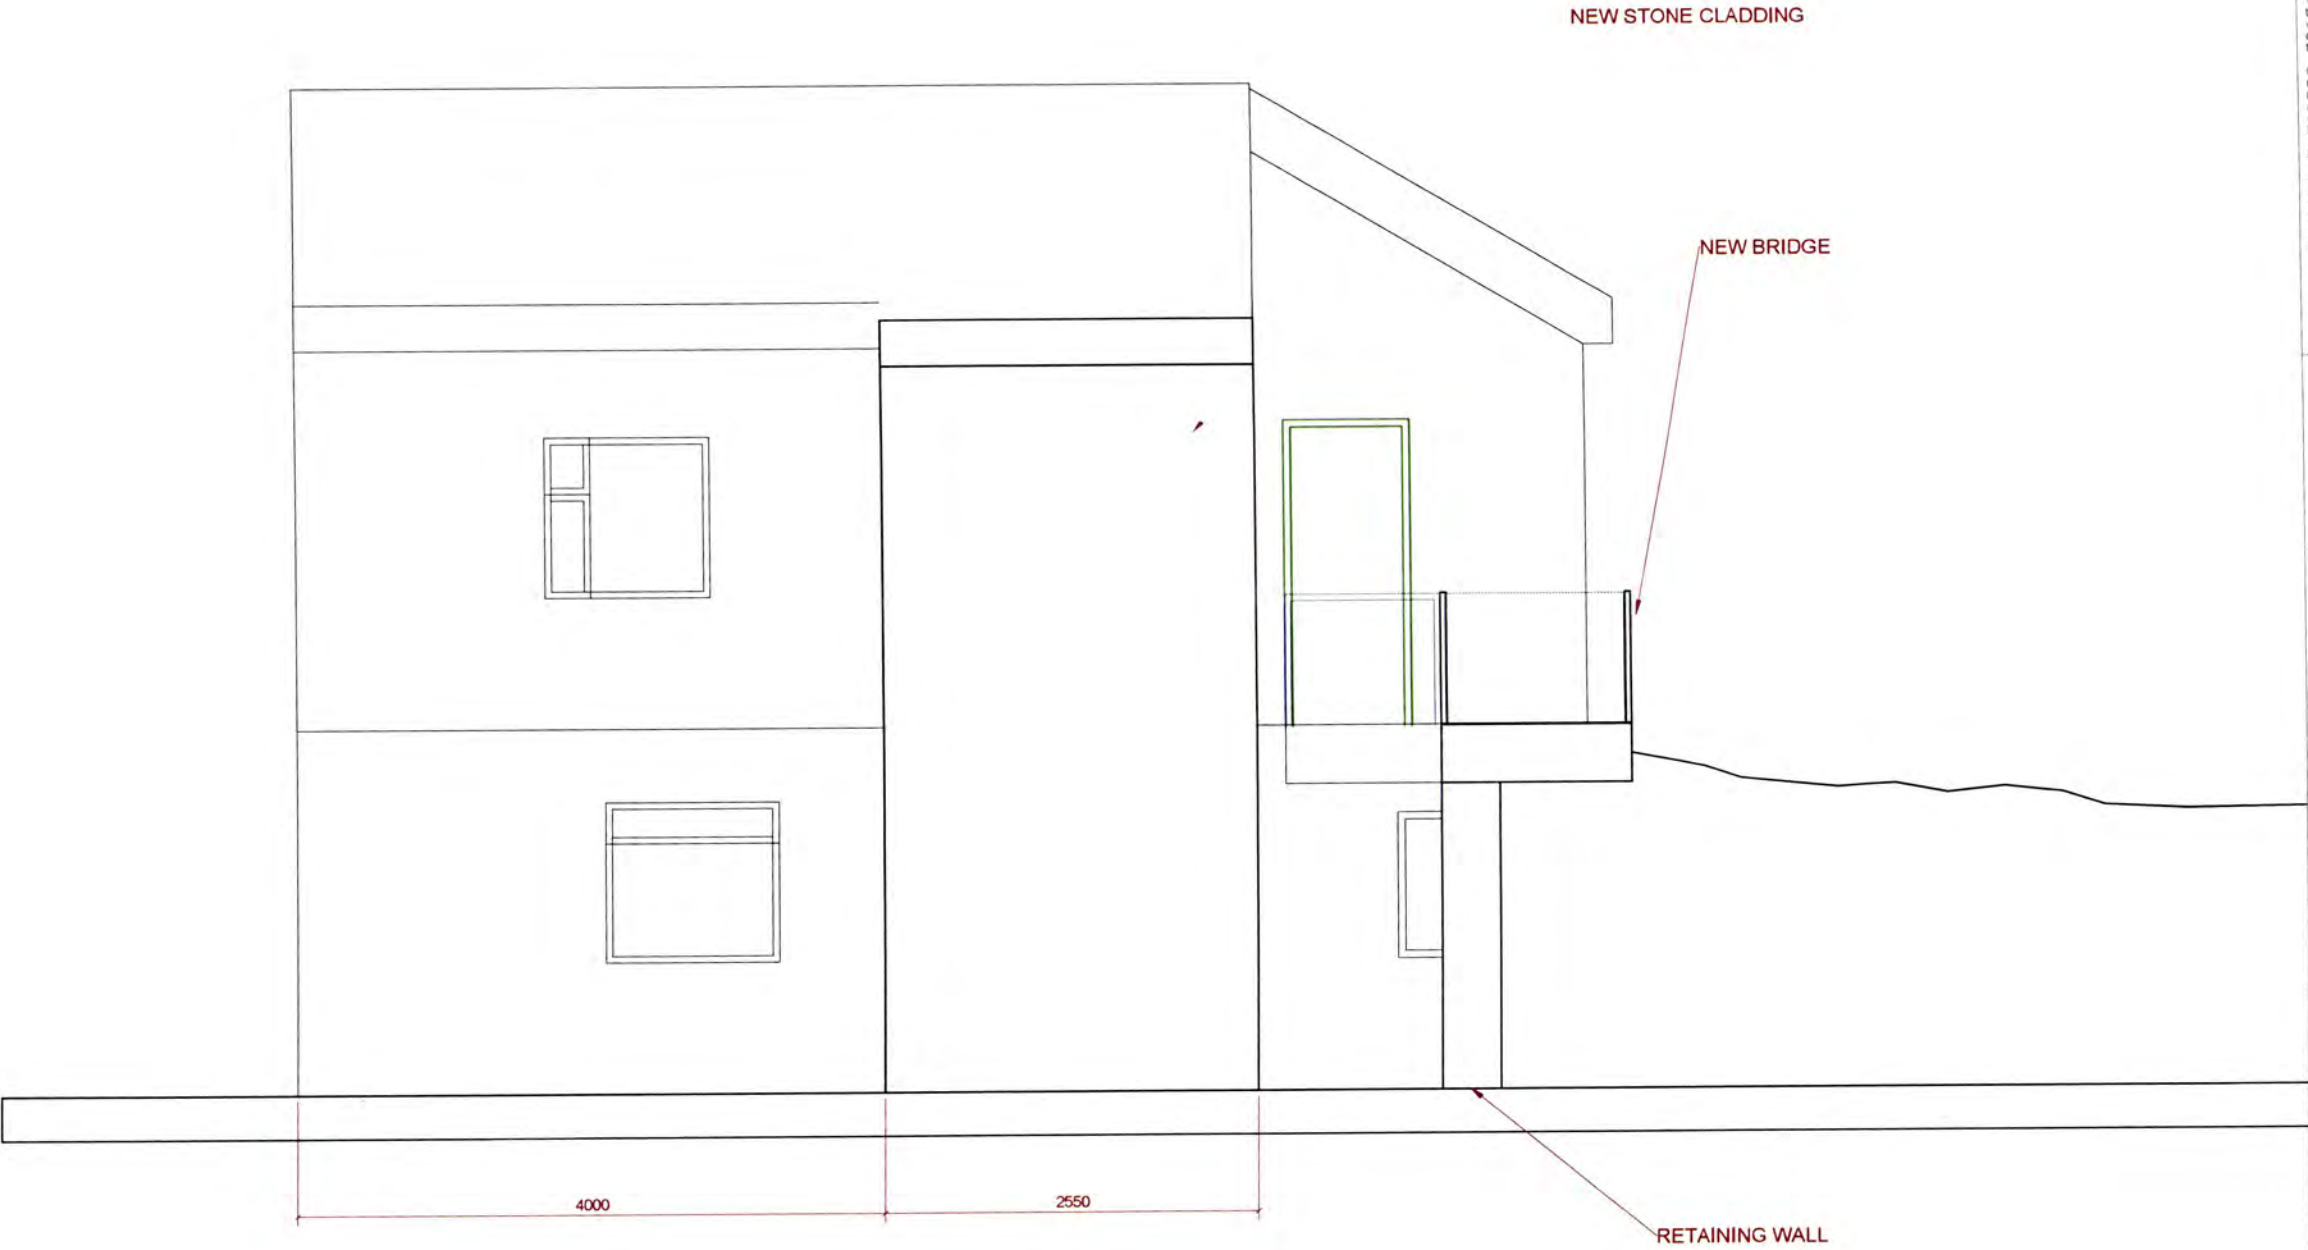

**Disclaimer - Use of this Information**  
**UNCONTROLLED INFORMATION**

This dwg document is an uncontrolled version issued to enable the recipient to use this information at their own risk. The issuer accepts no liability for any such use. Design development is ongoing and so may affect this dwg uncontrolled information. For controlled information refer to formally issued drawings and documents.  
**USE AT RECIPIENT'S RISK ONLY**

It is the duty of the recipients of electronic transmissions to be aware that their system may be corrupted by the opening of any such transmission and that they be satisfied that measures are in place to prevent such an occurrence.


No responsibility or liability whatsoever will be accepted by ZAP if the recipient's computer system is corrupted by information transmitted from ZAP computers and/or for any delays or other losses arising out of or caused by transmission.

Viruses. Although we have taken steps to ensure that this e-mail and attachments are free from any virus, we advise that in keeping with good computing practice the recipient should ensure they are actually virus free.

Confidentiality. This information is intended for the named recipients only and may be confidential. If it has come to you in error you must take no action based on the contents, nor must you copy or show them to anyone, please notify ZAP and highlight the error.

Please note that we work natively in AutoCAD which produces dwg format drawings and we are aware that line styles do not convert correctly between dwg and dgn formats. We therefore cannot guarantee the completeness or accuracy of the information in the issued dwg files and therefore the issued pdfs should always be used as a reference for the validity and accuracy of this information.

The contents of these drawings have been prepared solely for their use on this project and no other person or organisation should place reliance upon this information.

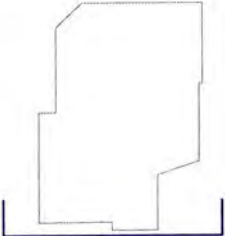


**PROPOSED**  
**PERMITTED DEVELOPMENT**

Work Package	Cost Check	Info/Briefing	Tender	Contract	Construction	Date	Revision	Description	Drawn by	Date	Ref.	Revision	Drawn by	Project	Subject	Project Code	Drawing Number	Rev.
						24.01.2022	A	Proposed elevation						HILLCREST, LOWER KINDELTOWN	PROPOSED ELEVATION HILLCREST, LOWER KINDELTOWN IRELAND	2203	255	C
						02.02.2022	B	Amending comments and changes made by client on 01.02.2022										
						17.02.2022	C	Amending comments and changes made by client on 14.02.2022										
Architects: ZAP Architecture, 369 High St, London, E15 4QZ, T: 020 37614969, E: info@zaparchitecture.com																		
															Date: 17.02.2022 Scale: 1:50 at A3			

© Copyright ZAP Architecture Ltd. Registered in England number: 08413192 Registered address: 369 High St, London E15 4QZ Use Figured Dimensions Only. All Dimensions to be checked on site. Original Drawing Size A3 (1)



PROPOSED ELEVATION 02

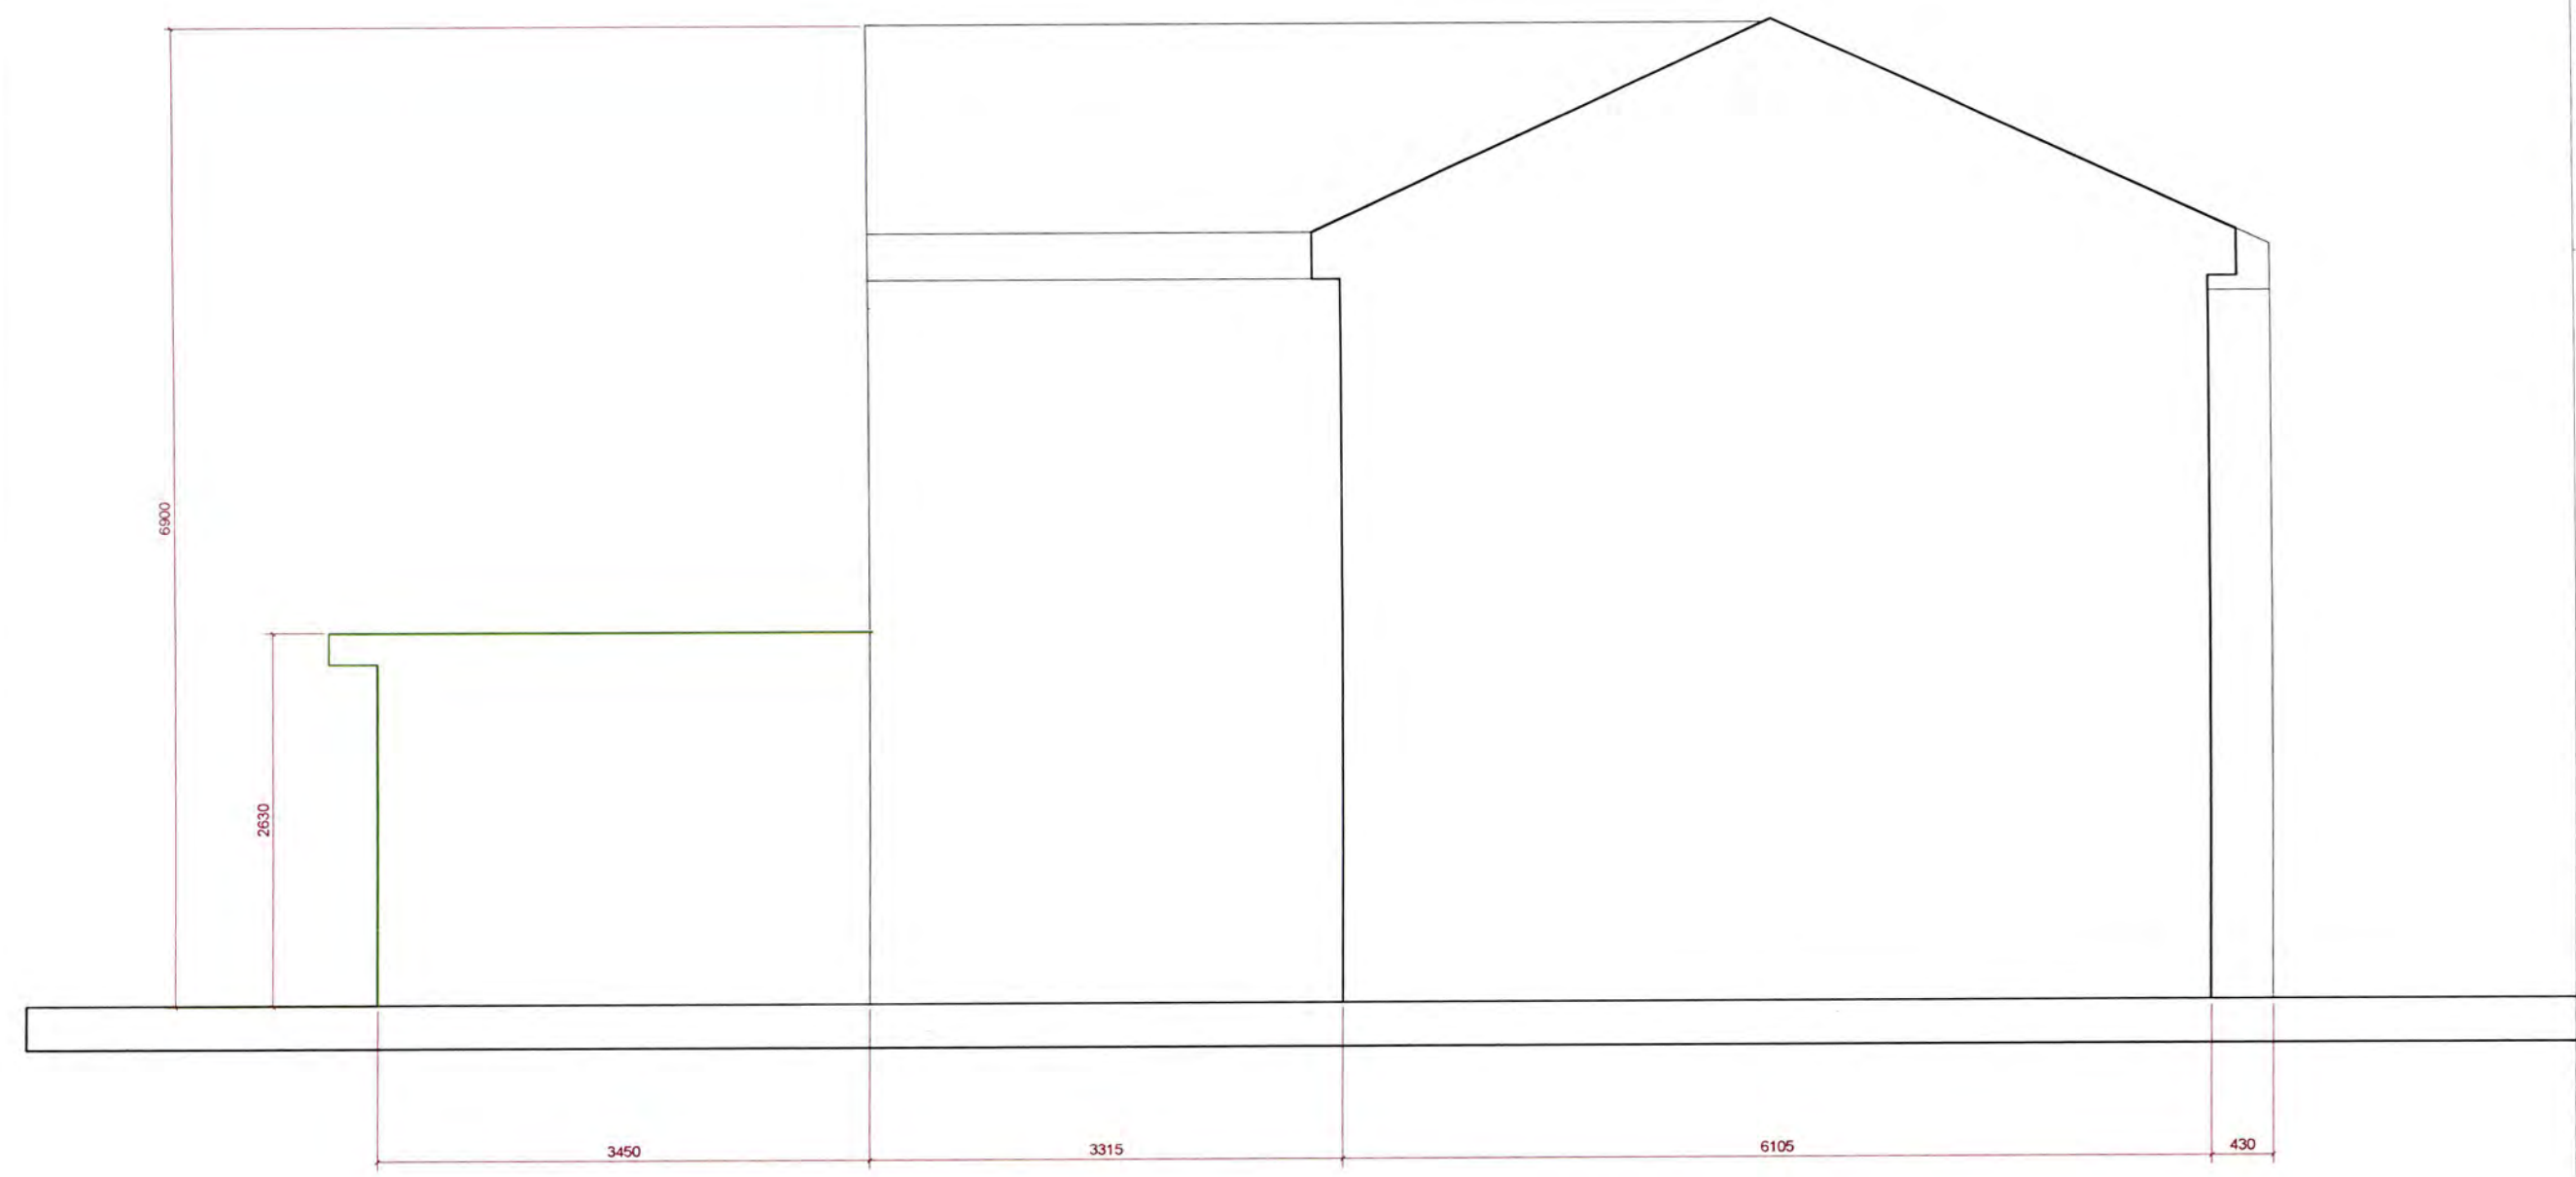

Disclaimer - Use of this Information  
UNCONTROLLED INFORMATION

This dwg document is an uncontrolled version issued to enable the recipient to use this information at their own risk. The issuer accepts no liability for any such use. Design development is ongoing and so may affect this dwg uncontrolled information. For controlled information refer to formally issued drawings and documents.  
USE AT RECIPIENT'S RISK ONLY

It is the duty of the recipients of electronic transmissions to be aware that their system may be corrupted by the opening of any such transmission and that they be satisfied that measures are in place to prevent such an occurrence.


No responsibility or liability whatsoever will be accepted by ZAP if the recipient's computer system is corrupted by information transmitted from ZAP computers and/or for any delays or other losses arising out of or caused by transmission.

Viruses: Although we have taken steps to ensure that this e-mail and attachments are free from any virus, we advise that in keeping with good computing practice the recipient should ensure they are actually virus free.

Confidentiality: This information is intended for the named recipients only and may be confidential. If it has come to you in error you must take no action based on the contents, nor must you copy or show them to anyone, please notify ZAP and highlight the error.

Please note that we work natively in AutoCAD which produces dwg format drawings and we are aware that line styles do not convert correctly between dwg and pdf formats. We therefore cannot guarantee the completeness or accuracy of the information in the issued dwg files and therefore the issued pdfs should always be used as a reference for the validity and accuracy of this information.

The contents of these drawings have been prepared solely for their use on this project and no other person or organisation should place reliance upon this information.

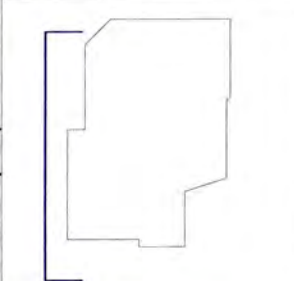


NEW PROPOSED (permitted development)

PROPOSED  
PERMITTED DEVELOPMENT

Work Package	Cost Check	Info/Briefing	Tender	Contract	Construction	Date	Revision	Description	Drawn by	Date	Ref.	Revision	Drawn by	Project	Subject	Architects	Project Code	Drawing Number	Rev.
						24.01.2022	A	Proposed elevation						HILLCREST, LOWER KINDELS TOWN	HILLCREST, LOWER KINDELS TOWN IRELAND	ZAP Architecture 365 High Street, London, E15 4QZ T: 020 37614886 E: info@zaparchitecture.com	2203	256	C
						02.02.2022	B	Amending comments and changes made by client on 01.02.2022											
						17.02.2022	C	Amending comments and changes made by client on 14.02.2022											




PROPOSED ELEVATION 03

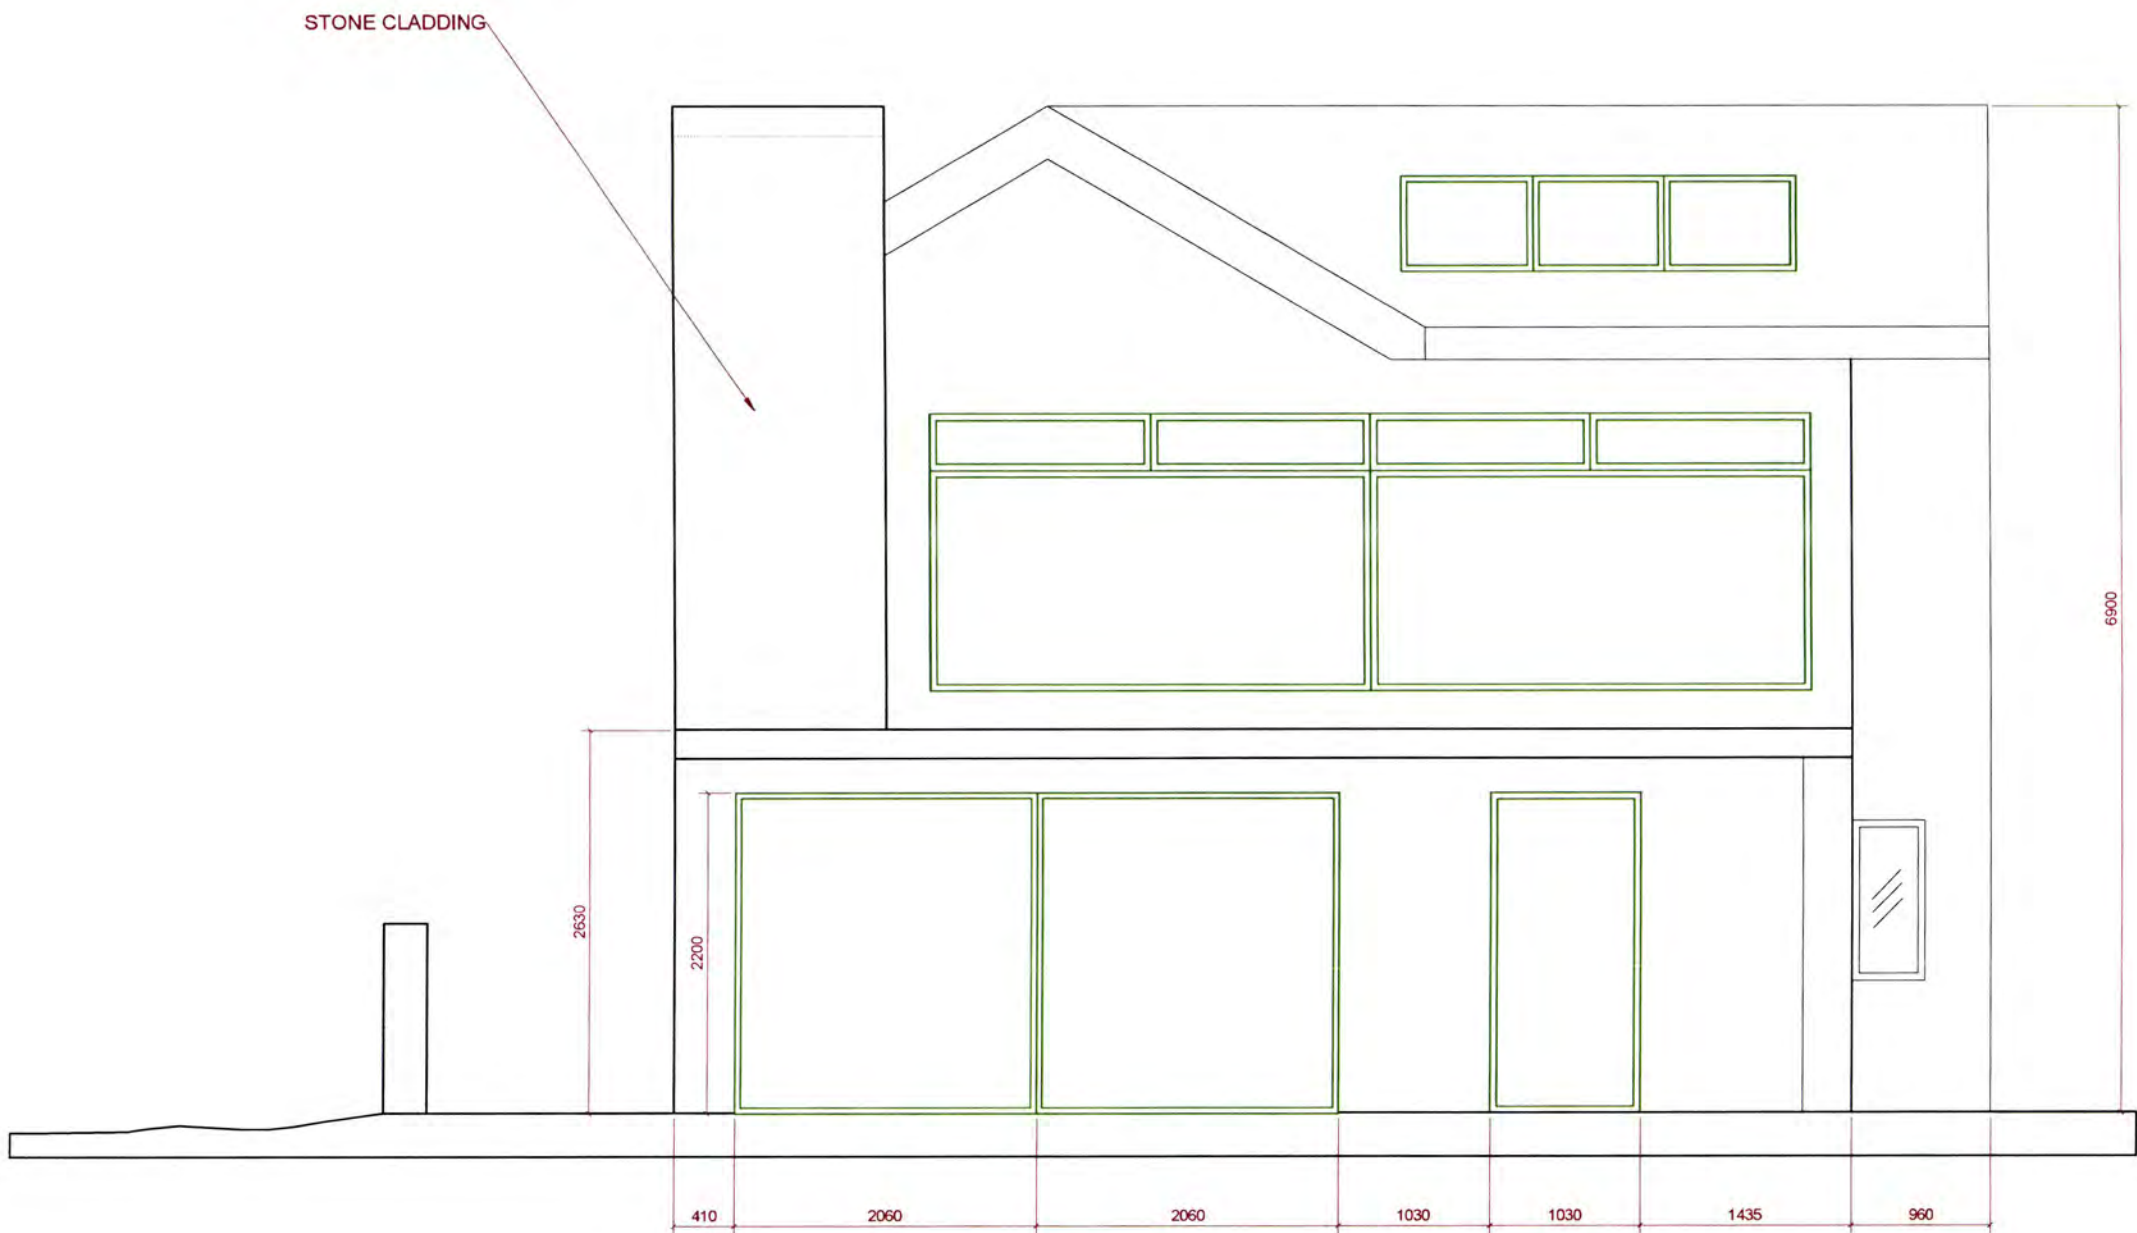

NEW PROPOSED (permitted development)

**Disclaimer - Use of this Information**  
**UNCONTROLLED INFORMATION**  
This dwg document is an uncontrolled version issued to enable the recipient to use this information at their own risk. The issuer accepts no liability for any such use. Design development is ongoing and so may affect this dwg uncontrolled information. For controlled information refer to formally issued drawings and documents. **USE AT RECIPIENT'S RISK ONLY.**  
It is the duty of the recipients of electronic transmissions to be aware that their system may be corrupted by the opening of any such transmission and that they be satisfied that measures are in place to prevent such an occurrence.  
No responsibility or liability whatsoever will be accepted by ZAP if the recipient's computer system is corrupted by information transmitted from ZAP computers and/or for any delays or other losses arising out of or caused by transmission.  
Viruses: Although we have taken steps to ensure that this e-mail and attachments are free from any virus, we advise that in keeping with good computing practice the recipient should ensure they are actually virus free.  
Confidentiality: This information is intended for the named recipients only and may be confidential. If it has come to you in error you must take no action based on the contents, nor must you copy or show them to anyone, please notify ZAP and highlight the error.  
Please note that we work natively in AutoCAD which produces dwg format drawings and we are aware that line styles do not convert correctly between dwg and dgn formats. We therefore cannot guarantee the completeness or accuracy of the information in the issued dwg files and therefore the issued pdfs should always be used as a reference for the validity and accuracy of this information.  
The contents of these drawings have been prepared solely for their use on this project and no other person or organisation should place reliance upon this information.

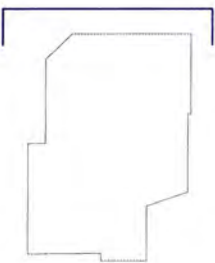

PROPOSED

**PERMITTED DEVELOPMENT**

Work Package	Cost Check	Info/Briefing	Tender	Contract	Construction	Date	Revision	Description	Drawn by	Date	Ref.	Revision	Drawn by	Project	Project Code	Drawing Number	Rev.
-						24.01.2022	A	Proposed elevation						HILLCREST, LOWER KINDELTOWN			
						02.02.2022	B	Amending comments and changes made by client on 01.02.2022						Subject	PROPOSED ELEVATION	2203	257
						17.02.2022	C	Amending comments and changes made by client on 14.02.2022						HILLCREST, LOWER KINDELTOWN IRELAND			C
														Architects	ZAP Architecture		
															395 High Street, London, E15 4GZ		
															T: 020 37614299 E: info@zaparchitecture.com		
															Date	17.02.2022	Scale 1:50 at A3



PROPOSED ELEVATION 04

**Disclaimer - Use of this Information**  
**UNCONTROLLED INFORMATION**

This dwg document is an uncontrolled version issued to enable the recipient to use this information at their own risk. The issuer accepts no liability for any such use. Design development is ongoing and so may affect this dwg uncontrolled information. For controlled information refer to formally issued drawings and documents.  
**USE AT RECIPIENT'S RISK ONLY**

It is the duty of the recipients of electronic transmissions to be aware that their system may be corrupted by the opening of any such transmission and that they be satisfied that measures are in place to prevent such an occurrence.

No responsibility or liability whatsoever will be accepted by ZAP if the recipient's computer system is corrupted by information transmitted from ZAP computers and/or for any delays or other losses arising out of or caused by transmission.


Viruses: Although we have taken steps to ensure that this e-mail and attachments are free from any virus, we advise that in keeping with good computing practice the recipient should ensure they are actually virus free.

Confidentiality: This information is intended for the named recipients only and may be confidential. If it has come to you in error you must take no action based on the contents, nor must you copy or show them to anyone, please notify ZAP and highlight the error.

Please note that we work natively in AutoCAD which produces dwg format drawings and we are aware that line styles do not convert correctly between dwg and dgn formats. We therefore cannot guarantee the completeness or accuracy of the information in the issued dwg files and therefore the issued pdfs should always be used as a reference for the validity and accuracy of this information.


The contents of these drawings have been prepared solely for their use on this project and no other person or organisation should place reliance upon this information.

ZAP

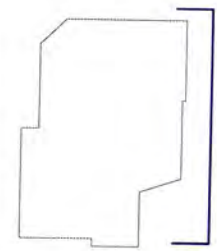

**PROPOSED**  
**PERMITTED DEVELOPMENT**

NEW STONE CLADDING

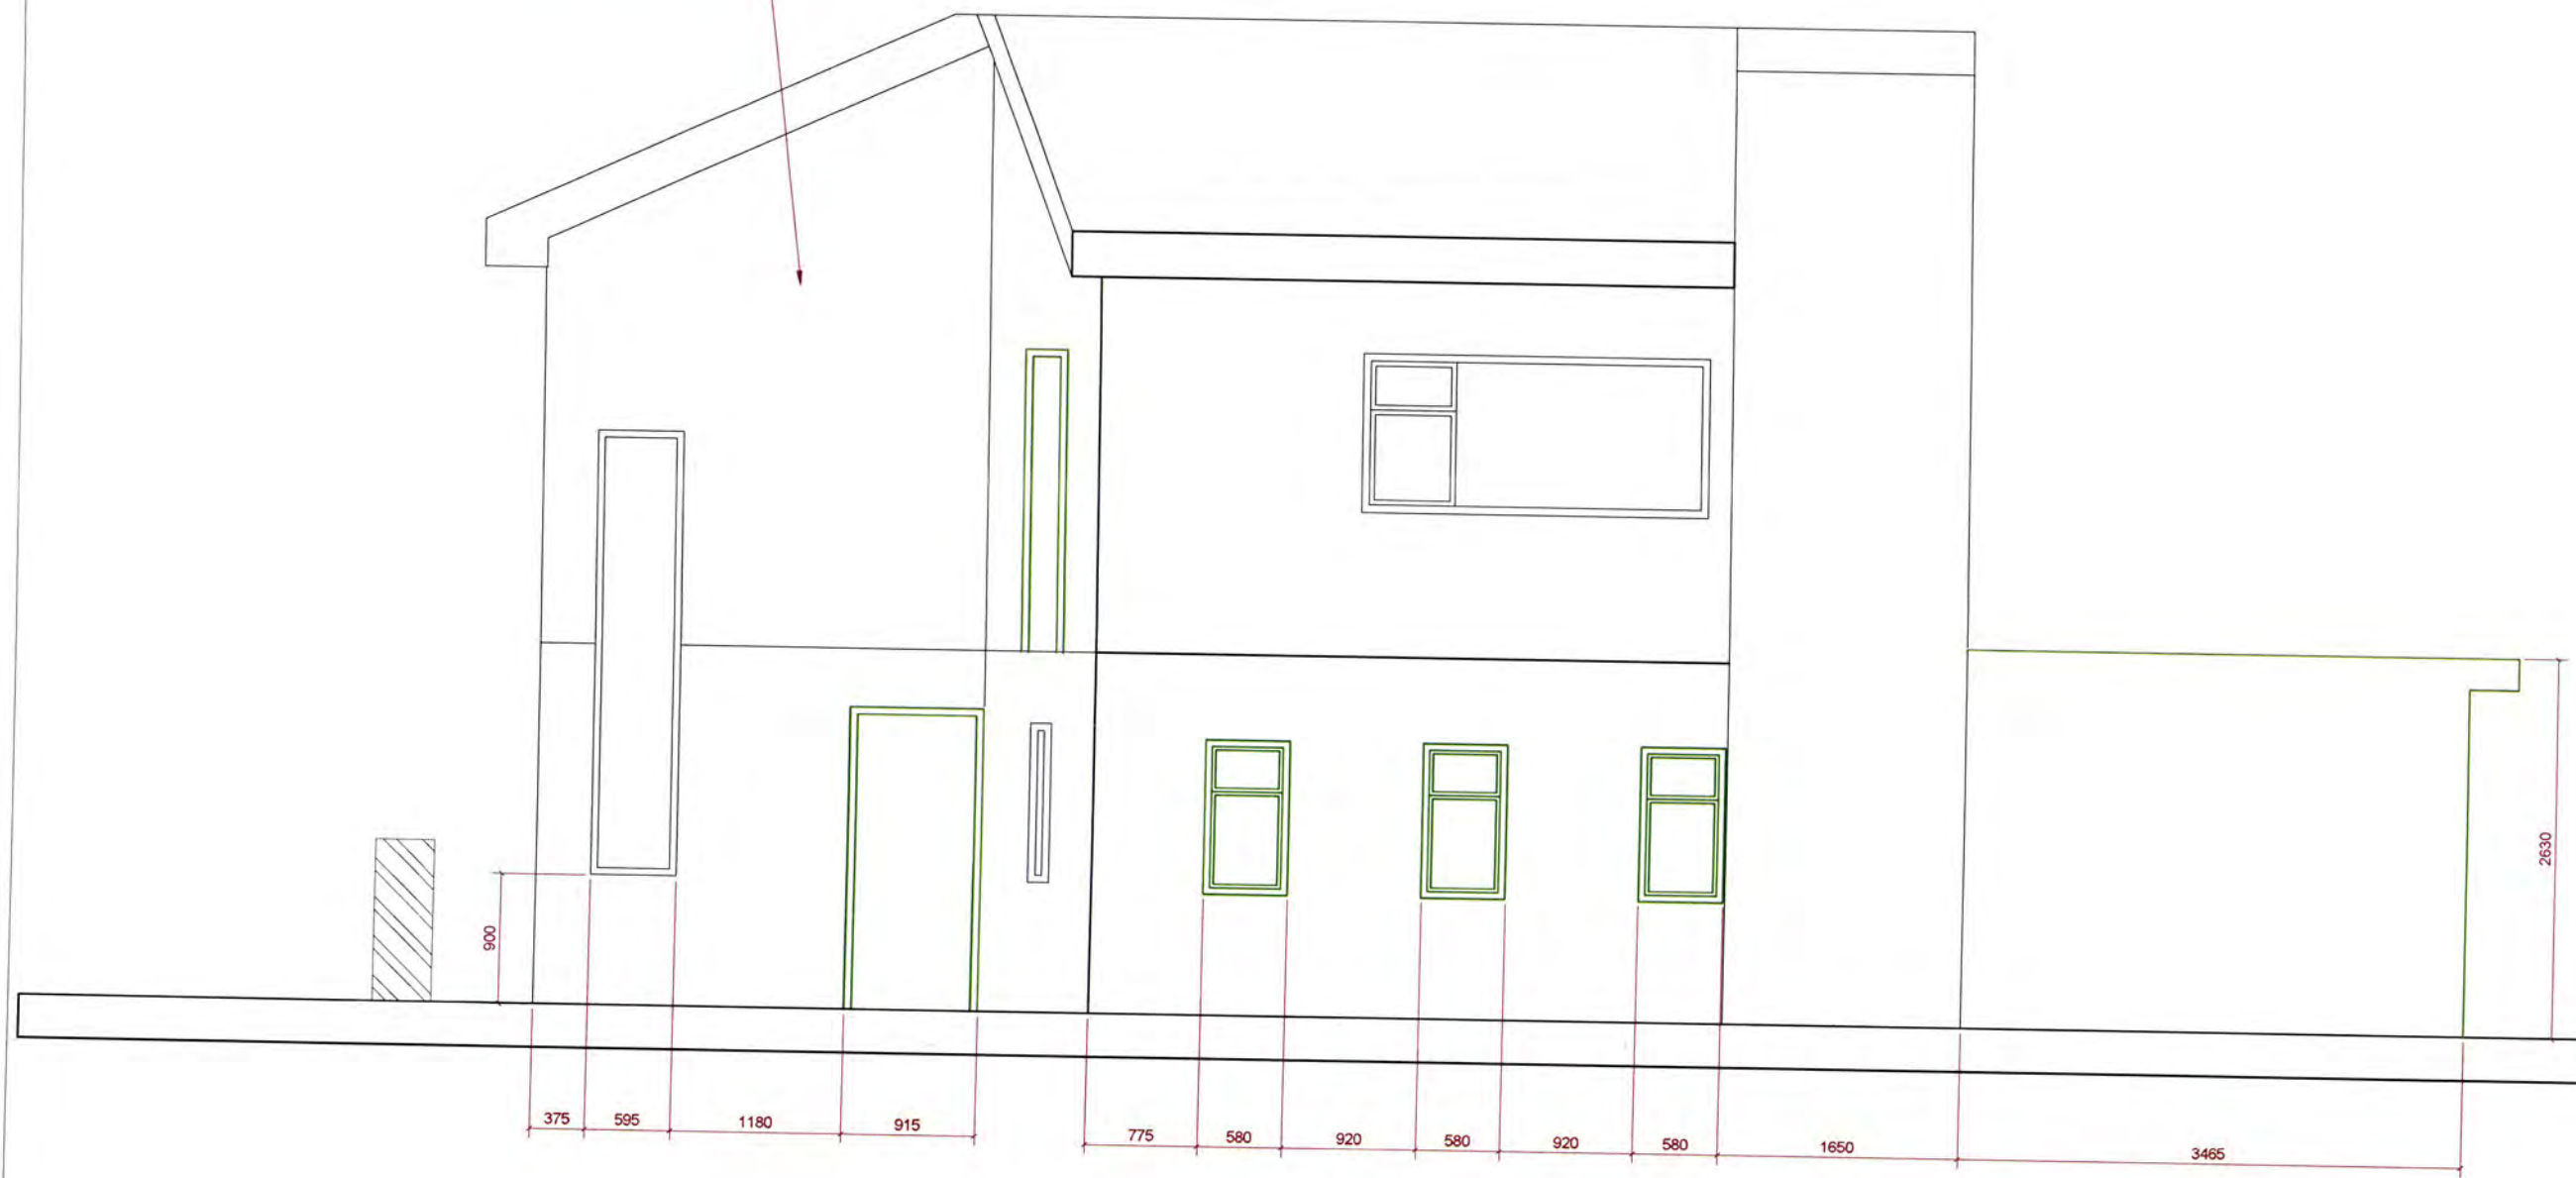


NEW PROPOSED (permitted development)

Work Package	Cost Check	Info/Briefing	Tender	Contract	Construction	Date	Revision	Description	Drawn by	Date	Ref.	Revision	Drawn by	Project	Subject	Architects	Project Code	Drawing Number	Rev.
						24.01.2022	A	Proposed elevation						HILLCREST, LOWER KINDELS TOWN	HILLCREST, LOWER KINDELS TOWN IRELAND	ZAP Architecture 305 High Street, London, E15 4QZ T: 020 37614996 E: info@zaparchitecture.com	2203	258	C
						02.02.2022	B	Amending comments and changes made by client on 01.02.2022											
						17.02.2022	C	Amending comments and changes made by client on 14.02.2022											

© Copyright ZAP Architecture Ltd. Registered in England number: 08413192 Registered address: 305 High St, London E15 4QZ Use Figured Dimensions Only. All Dimensions to be checked on site. Original Drawing Size A3 (L)





PROPOSED SECTION AA

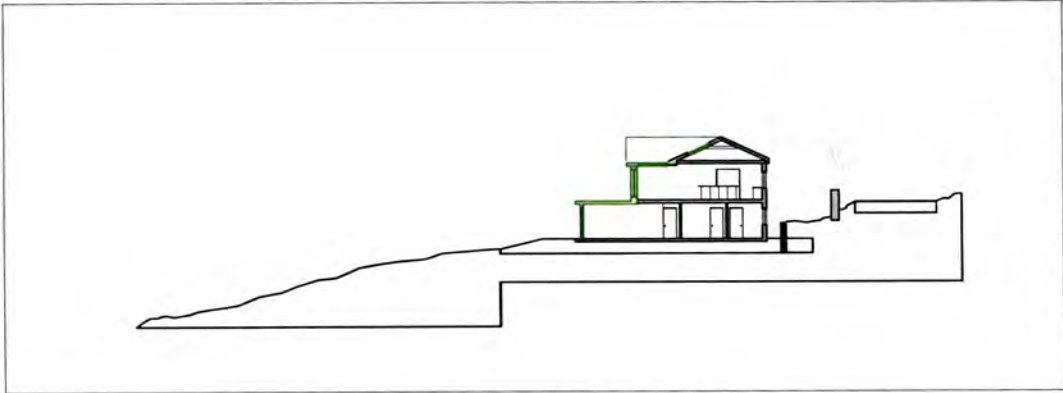

KEY SECTION AA 1:500

**Disclaimer - Use of this Information**  
**UNCONTROLLED INFORMATION**  
This dwg document is an uncontrolled version issued to enable the recipient to use this information at their own risk. The issuer accepts no liability for any such use. Design development is ongoing and so may affect this dwg uncontrolled information. For controlled information refer to formally issued drawings and documents. **USE AT RECIPIENT'S RISK ONLY**  
It is the duty of the recipients of electronic transmissions to be aware that their system may be corrupted by the opening of any such transmission and that they be satisfied that measures are in place to prevent such an occurrence.  
No responsibility or liability whatsoever will be accepted by ZAP if the recipient's computer system is corrupted by information transmitted from ZAP computers and/or for any delays or other losses arising out of or caused by transmission.  
Viruses. Although we have taken steps to ensure that this e-mail and attachments are free from any virus, we advise that in keeping with good computing practice the recipient should ensure they are actually virus free.  
Confidentiality. This information is intended for the named recipients only and may be confidential. If it has come to you in error you must take no action based on the contents, nor must you copy or show them to anyone, please notify ZAP and highlight the error.  
Please note that we work natively in AutoCAD which produces dwg format drawings and we are aware that line styles do not convert correctly between dwg and dgn formats. We therefore cannot guarantee the completeness or accuracy of the information in the issued dwg files and therefore the issued pdfs should always be used as a reference for the validity and accuracy of this information.  
The contents of these drawings have been prepared solely for their use on this project and no other person or organisation should place reliance upon this information.

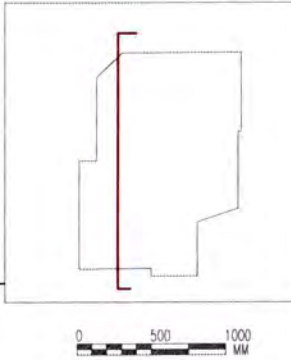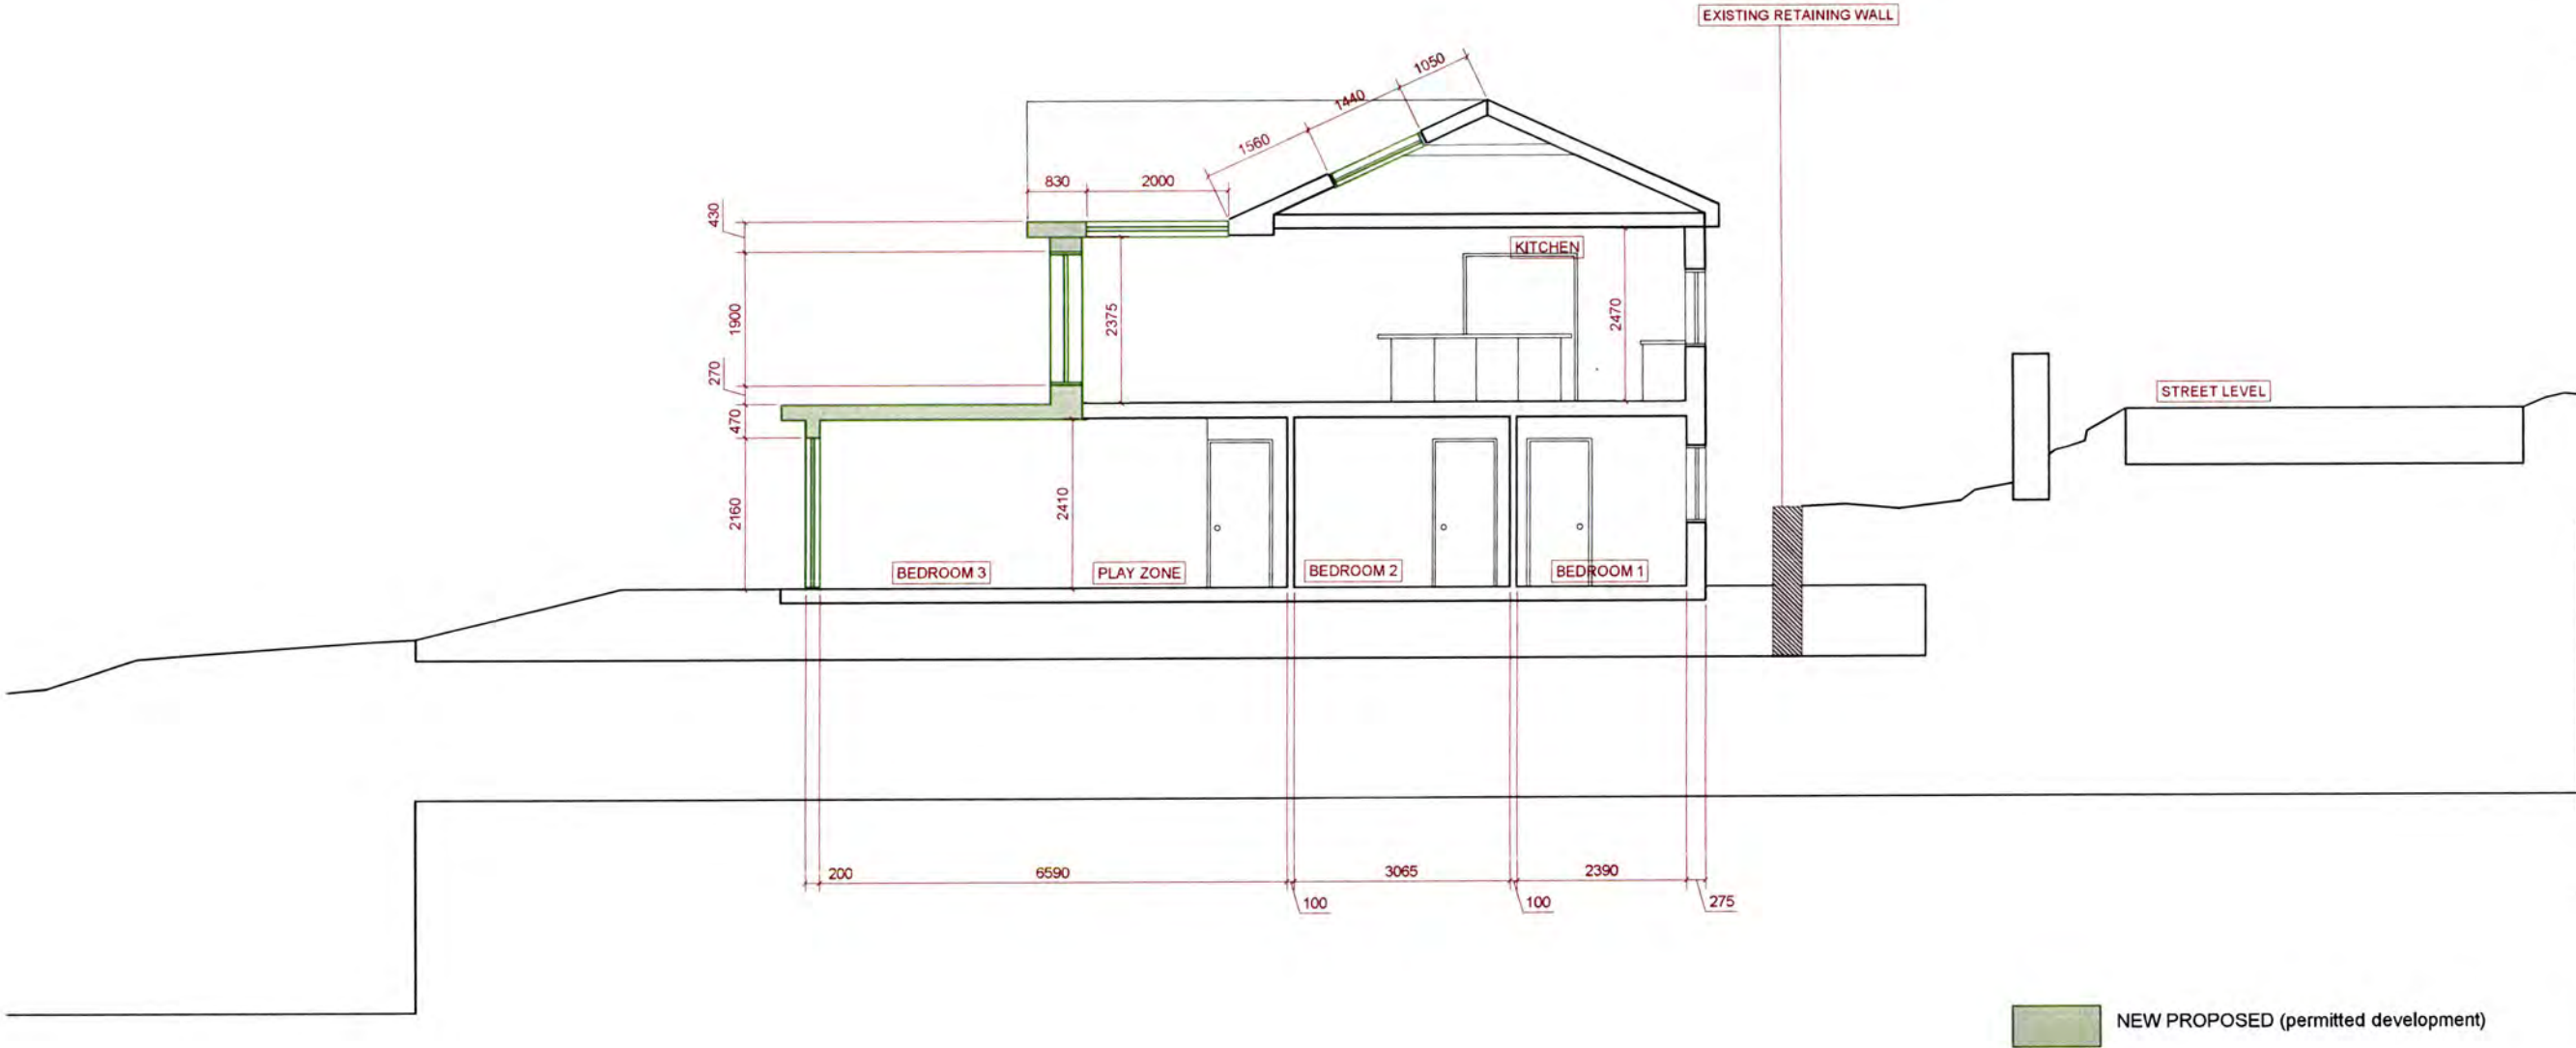

**PROPOSED**  
**PERMITTED DEVELOPMENT**

Work Package	Cost Check	Info/Sheeting	Tender	Contract	Construction	Date	Revision	Description	Drawn by	Date	Ref	Revision	Drawn by	Project	Subject	Architects	Project Code	Drawing Number	Rev.
						24.01.2022	A	Proposed section						HILLCREST, LOWER KINDELS TOWN	HILLCREST, LOWER KINDELS TOWN IRELAND	ZAP Architecture 395 High Street, London E15 4QZ T: 020 37614999 E: info@zaparchitecture.com	2203	353	C
						02.02.2022	B	Amending comments and changes made by client on 01.02.2022											
						17.02.2022	C	Amending comments and changes made by client on 14.02.2022											



## PROPOSED SECTION BB

**Disclaimer - Use of this Information**

**UNCONTROLLED INFORMATION**

This dwg document is an uncontrolled version issued to enable the recipient to use this information at their own risk. The issuer accepts no liability for any such use. Design development is ongoing and so may affect the accuracy of this controlled information.

For controlled information refer to formally issued drawings and documents.

**USE AT RECIPIENT'S RISK ONLY**

It is the duty of the recipients of electronic transmissions to be aware that their system may be corrupted by the receipt of data of such transmission and that they be satisfied that measures are in place to prevent such an occurrence.


No responsibility or liability whatsoever will be accepted by ZAP if the recipient's computer system is corrupted by information transmitted from ZAP computers and/or for any delays or other losses arising out of or caused by transmission.

Viruses. Although we have taken steps to ensure that this e-mail and attachments are free from any virus, we advise that in keeping with good computing practice the recipient should ensure they are actually virus free.

Confidentiality. This information is intended for the named recipients only and may be confidential. If it has come to you in error you must take no action and inform the sender immediately. Do not copy or show them to anyone, please notify ZAP and highlight the error.


Please note that we work naturally in AutoCAD which produces dwg format drawings and we are aware that lines may not convert correctly between dwg and dxf formats. We therefore cannot guarantee the completeness or accuracy of the information as the issued dwg files and therefore the issued pdf should always be used as a reference for the validity and accuracy of this information.

The contents of these drawings have been prepared solely for the use on this project and no other version or interpretation should place reliance upon this information.

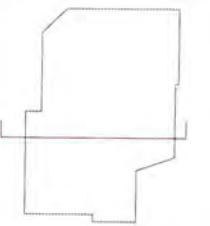

PROPOSED

PERMITTED DEVELOPMENT

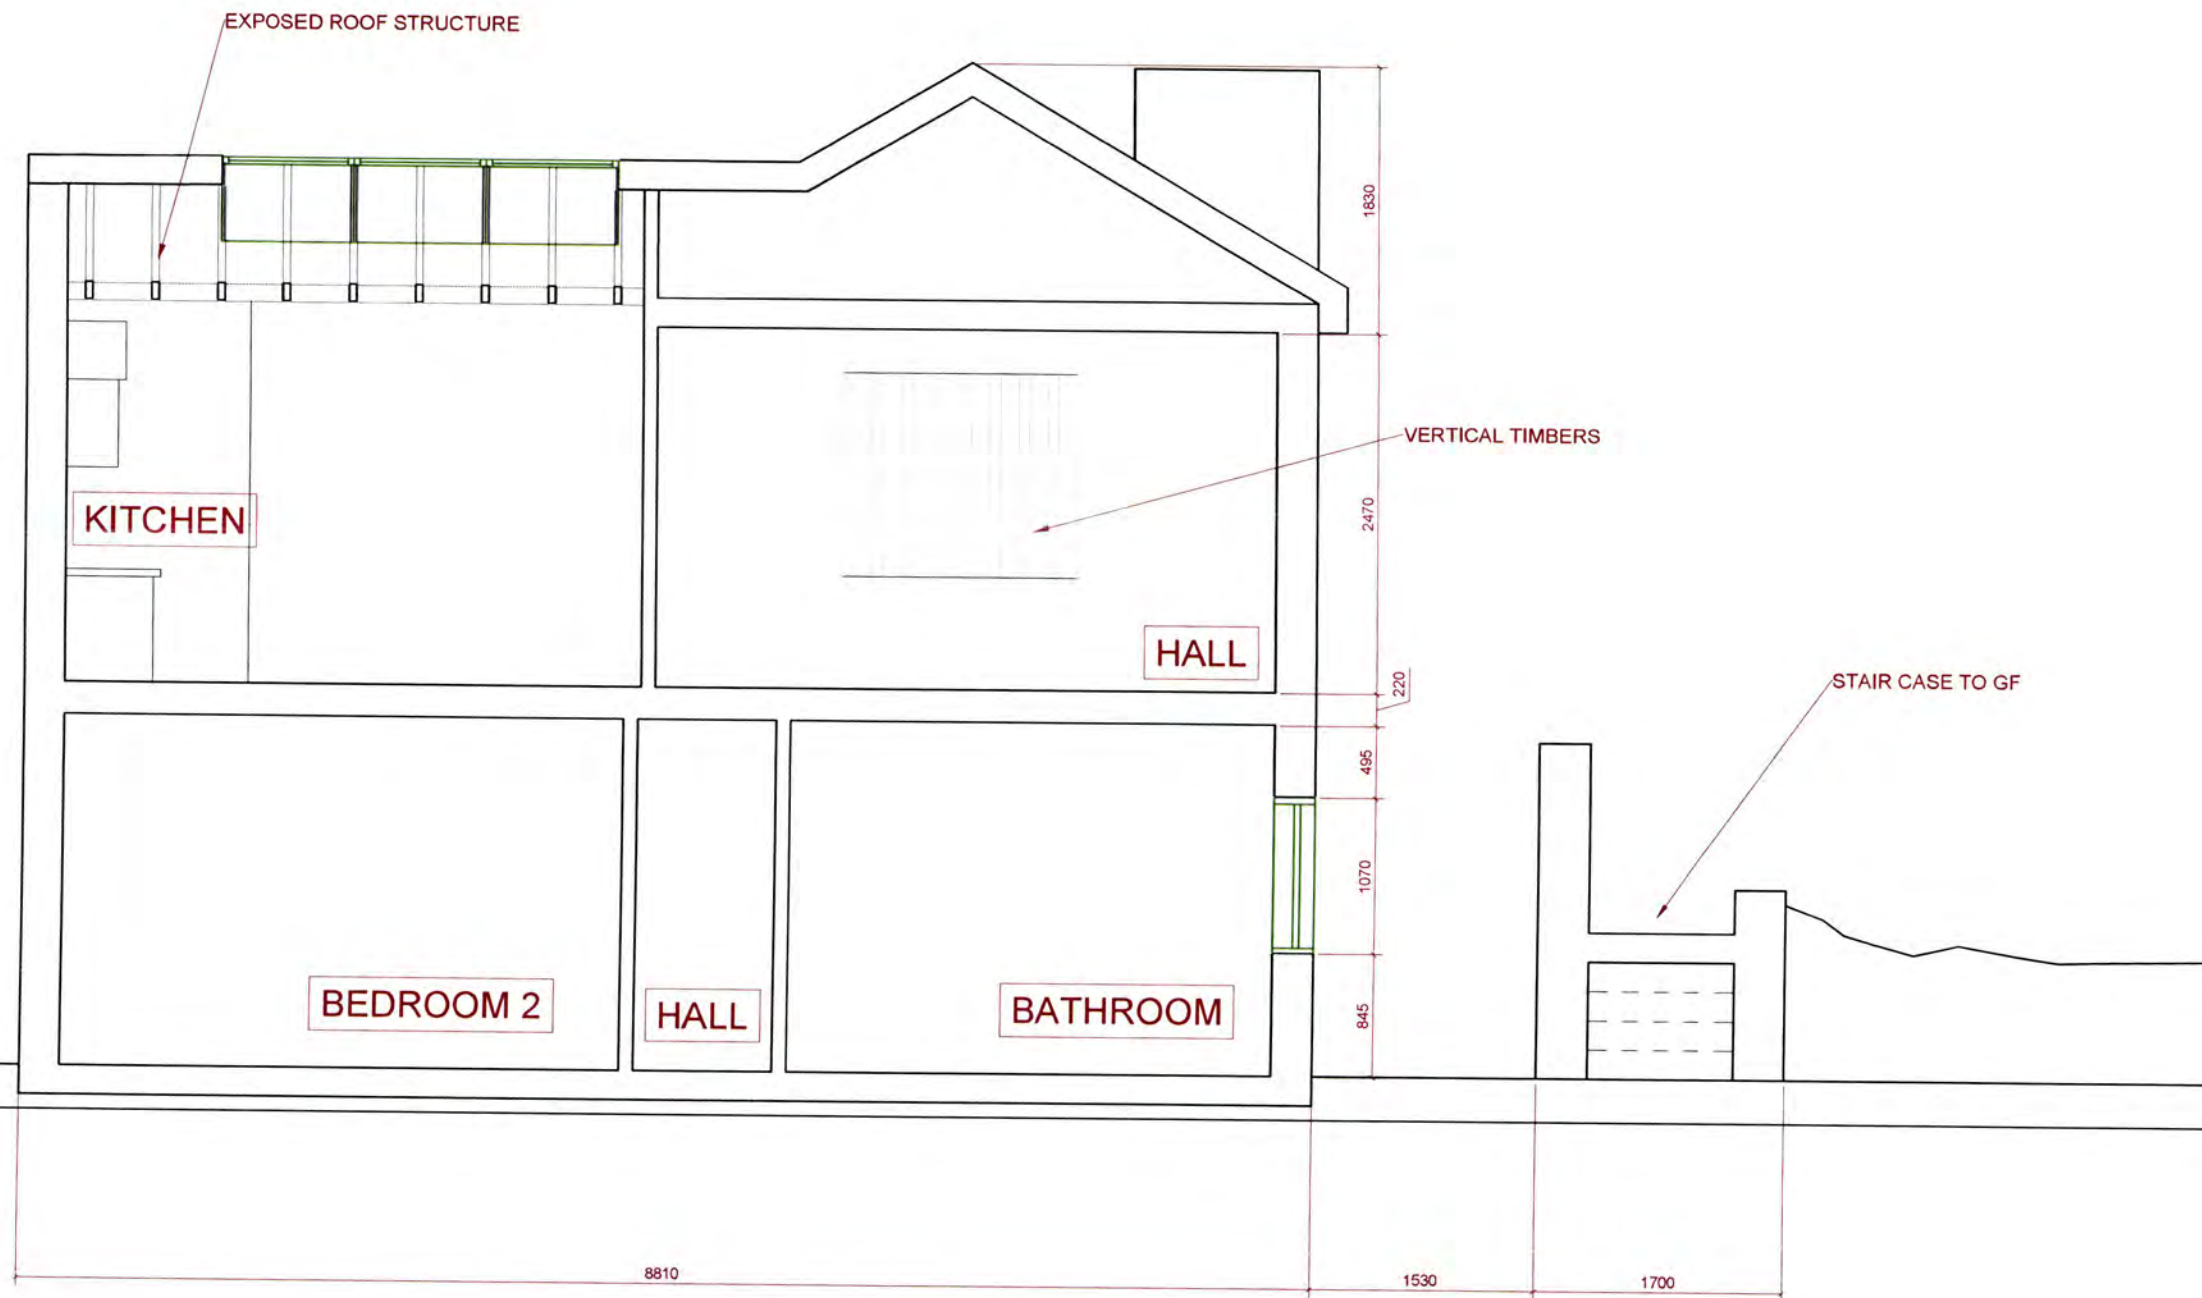

NEW PROPOSED (permitted development)

[illegible]



PROPOSED SECTION CC

Disclaimer - Use of this Information  
UNCONTROLLED INFORMATION

This dwg document is an uncontrolled version issued to enable the recipient to use this information at their own risk. The issuer accepts no liability for any such use. Design development is ongoing and so may affect this dwg uncontrolled information. For controlled information refer to formally issued drawings and documents. USE AT RECIPIENT'S RISK ONLY.

It is the duty of the recipients of electronic transmissions to be aware that their system may be corrupted by the opening of any such transmission and that they be satisfied that measures are in place to prevent such an occurrence.

No responsibility or liability whatsoever will be accepted by ZAP if the recipient's computer system is corrupted by information transmitted from ZAP computers and/or for any delays or other losses arising out of or caused by transmission.

Viruses. Although we have taken steps to ensure that this e-mail and attachments are free from any virus, we advise that in keeping with good computing practice the recipient should ensure they are actually virus free.

Confidentiality. This information is intended for the named recipients only and may be confidential. If it has come to you in error you must take no action based on the contents, nor must you copy or show them to anyone, please notify ZAP and highlight the error.


Please note that we work natively in AutoCAD which produces dwg format drawings and we are aware that line styles do not convert correctly between dwg and dgn formats. We therefore cannot guarantee the completeness or accuracy of the information in the issued dwg files and therefore the issued pdfs should always be used as a reference for the validity and accuracy of this information.

The contents of these drawings have been prepared solely for their use on this project and no other person or organisation should place reliance upon this information.



PROPOSED

PERMITTED DEVELOPMENT

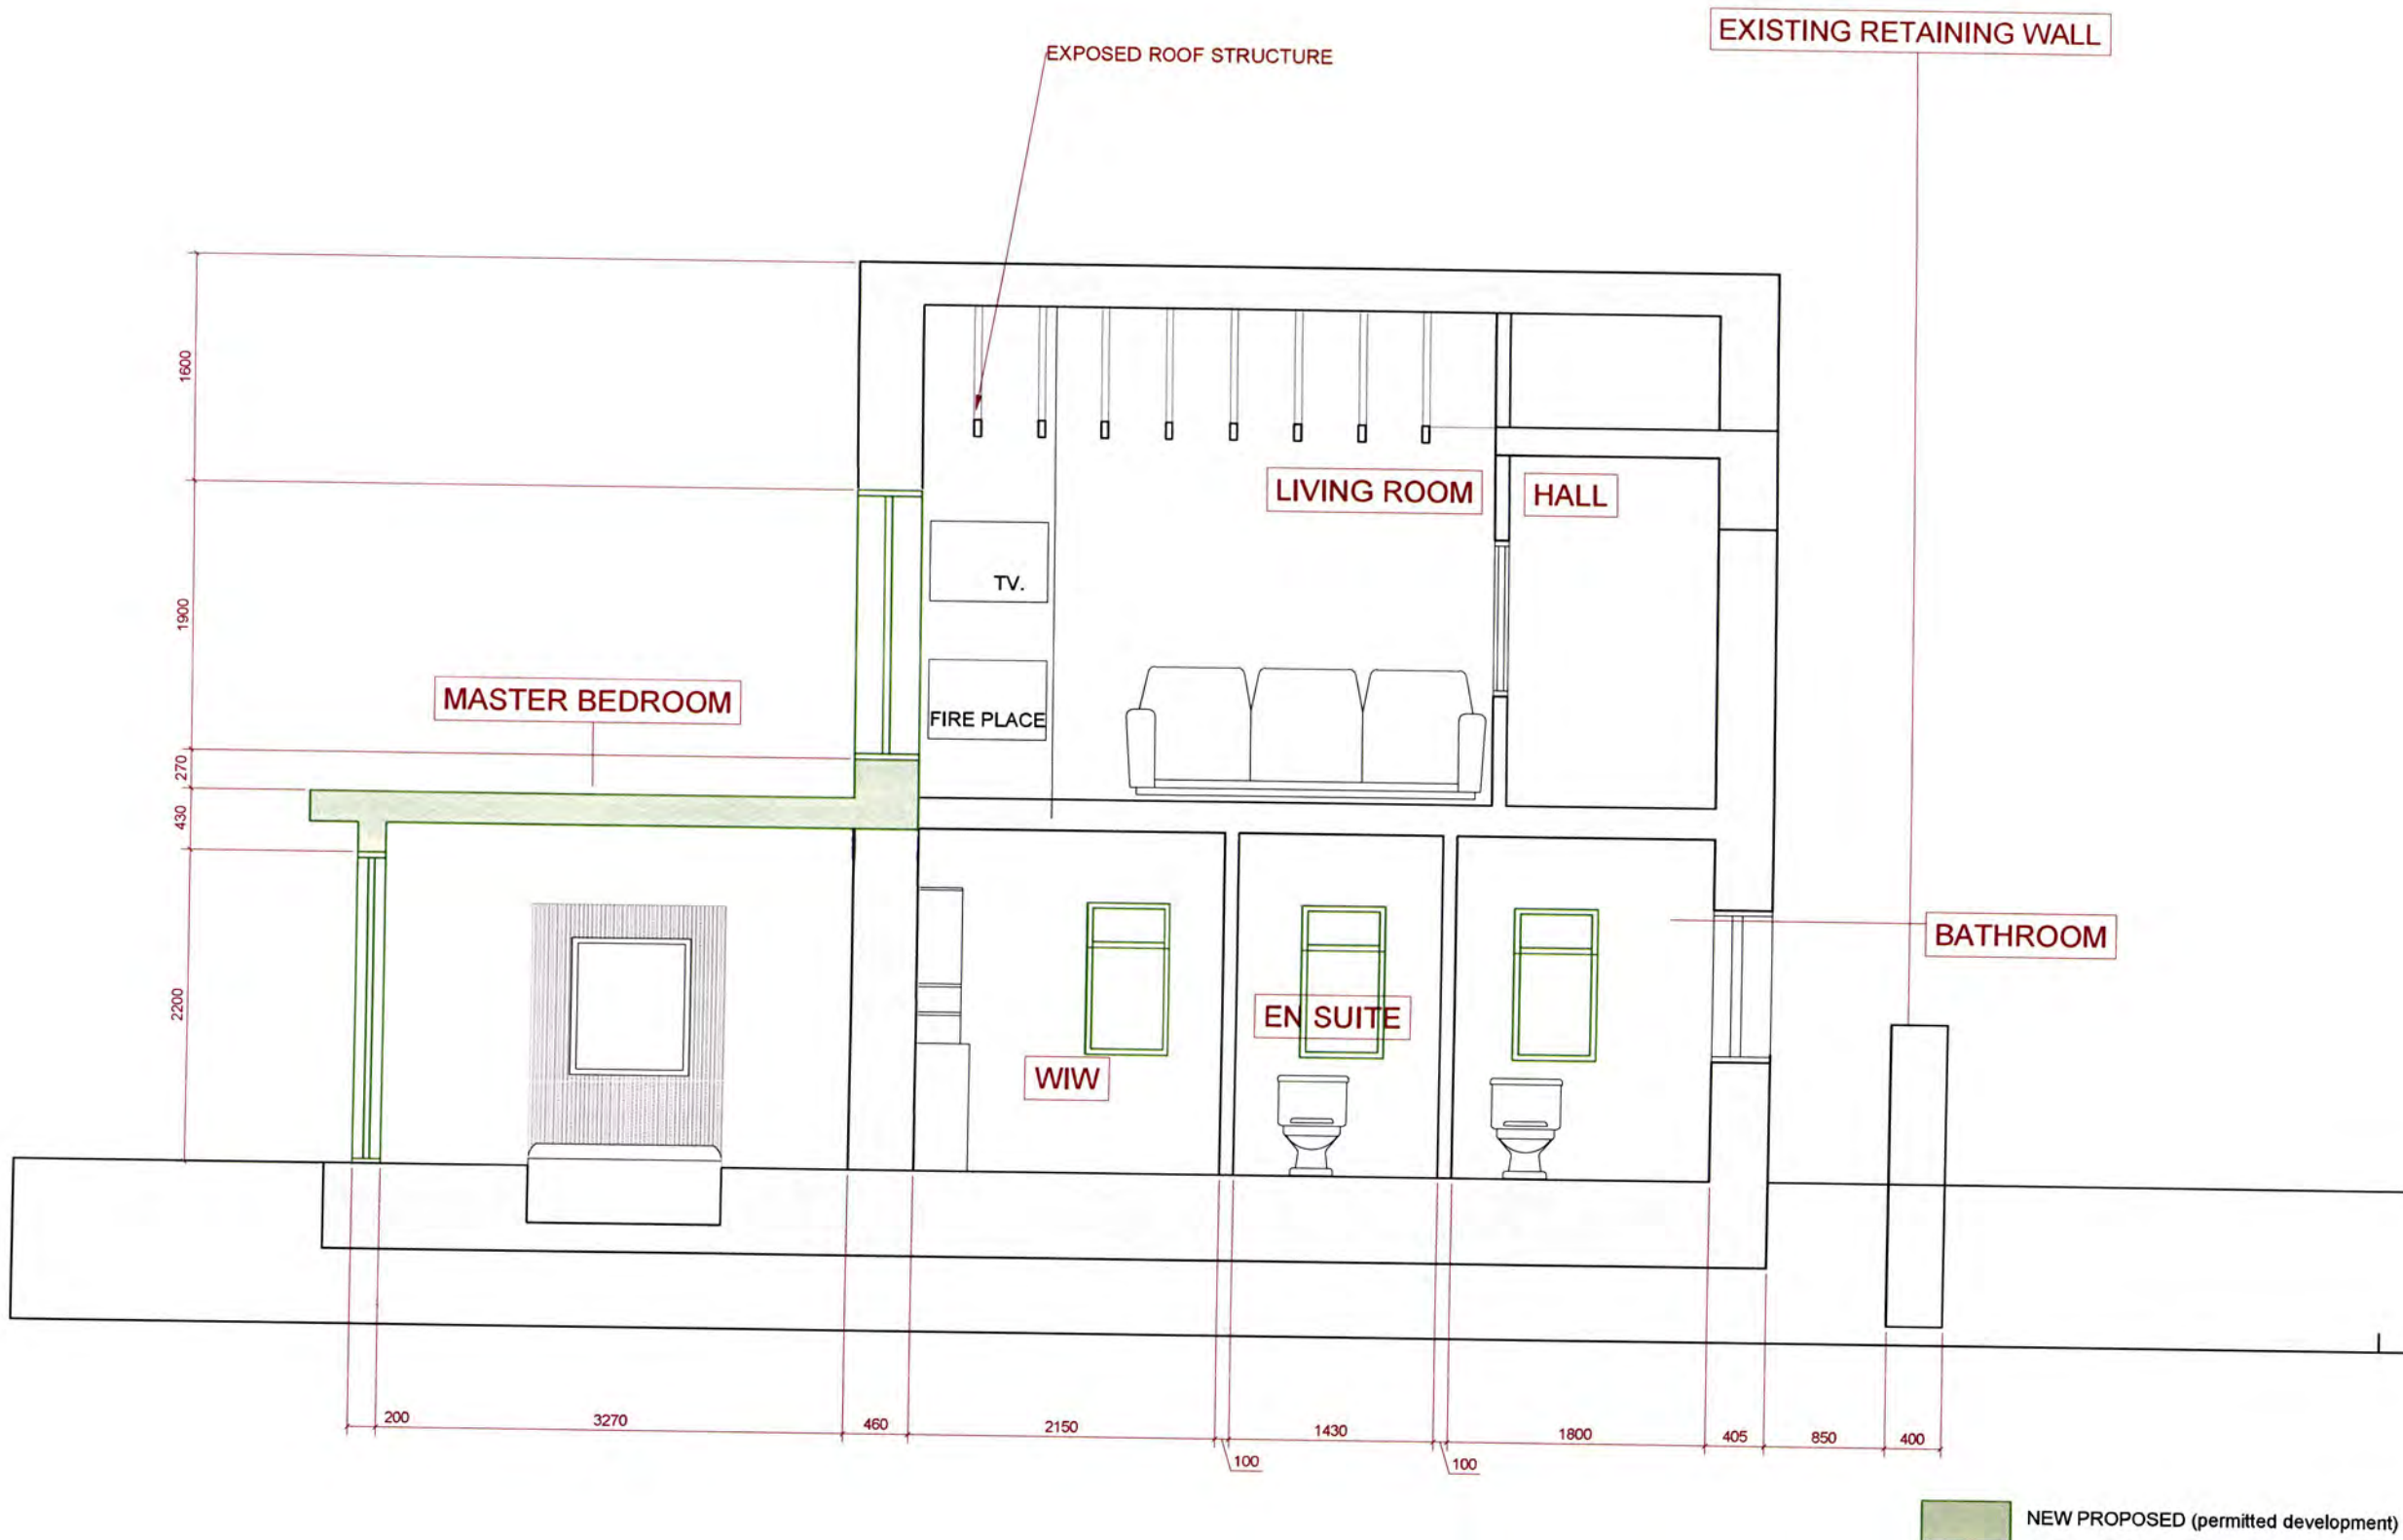

Work Package	Cost Check	Info/Briefing	Tender	Contract	Construction	Date	Revision	Description	Drawn by	Date	Ref.	Revision	Drawn by	Project	Subject	Project Code	Drawing Number	Rev.
						24.01.2022	A	Proposed section						HILLCREST, LOWER KINDELS TOWN	HILLCREST, LOWER KINDELS TOWN IRELAND	2203	255	C
						02.02.2022	B	Amending comments and changes made by client on 01.02.2022										
						17.02.2022	C	Amending comments and changes made by client on 14.02.2022										


Architects	ZAP Architecture 368 High Street, London, E15 4GZ T: 020 3751 4006 E: info@zaparchitecture.com
Date	17.02.2022
Scale	1:50 at A3



# PROPOSED EXTERNAL VISUALS




# AXONOMETRIC VIEW

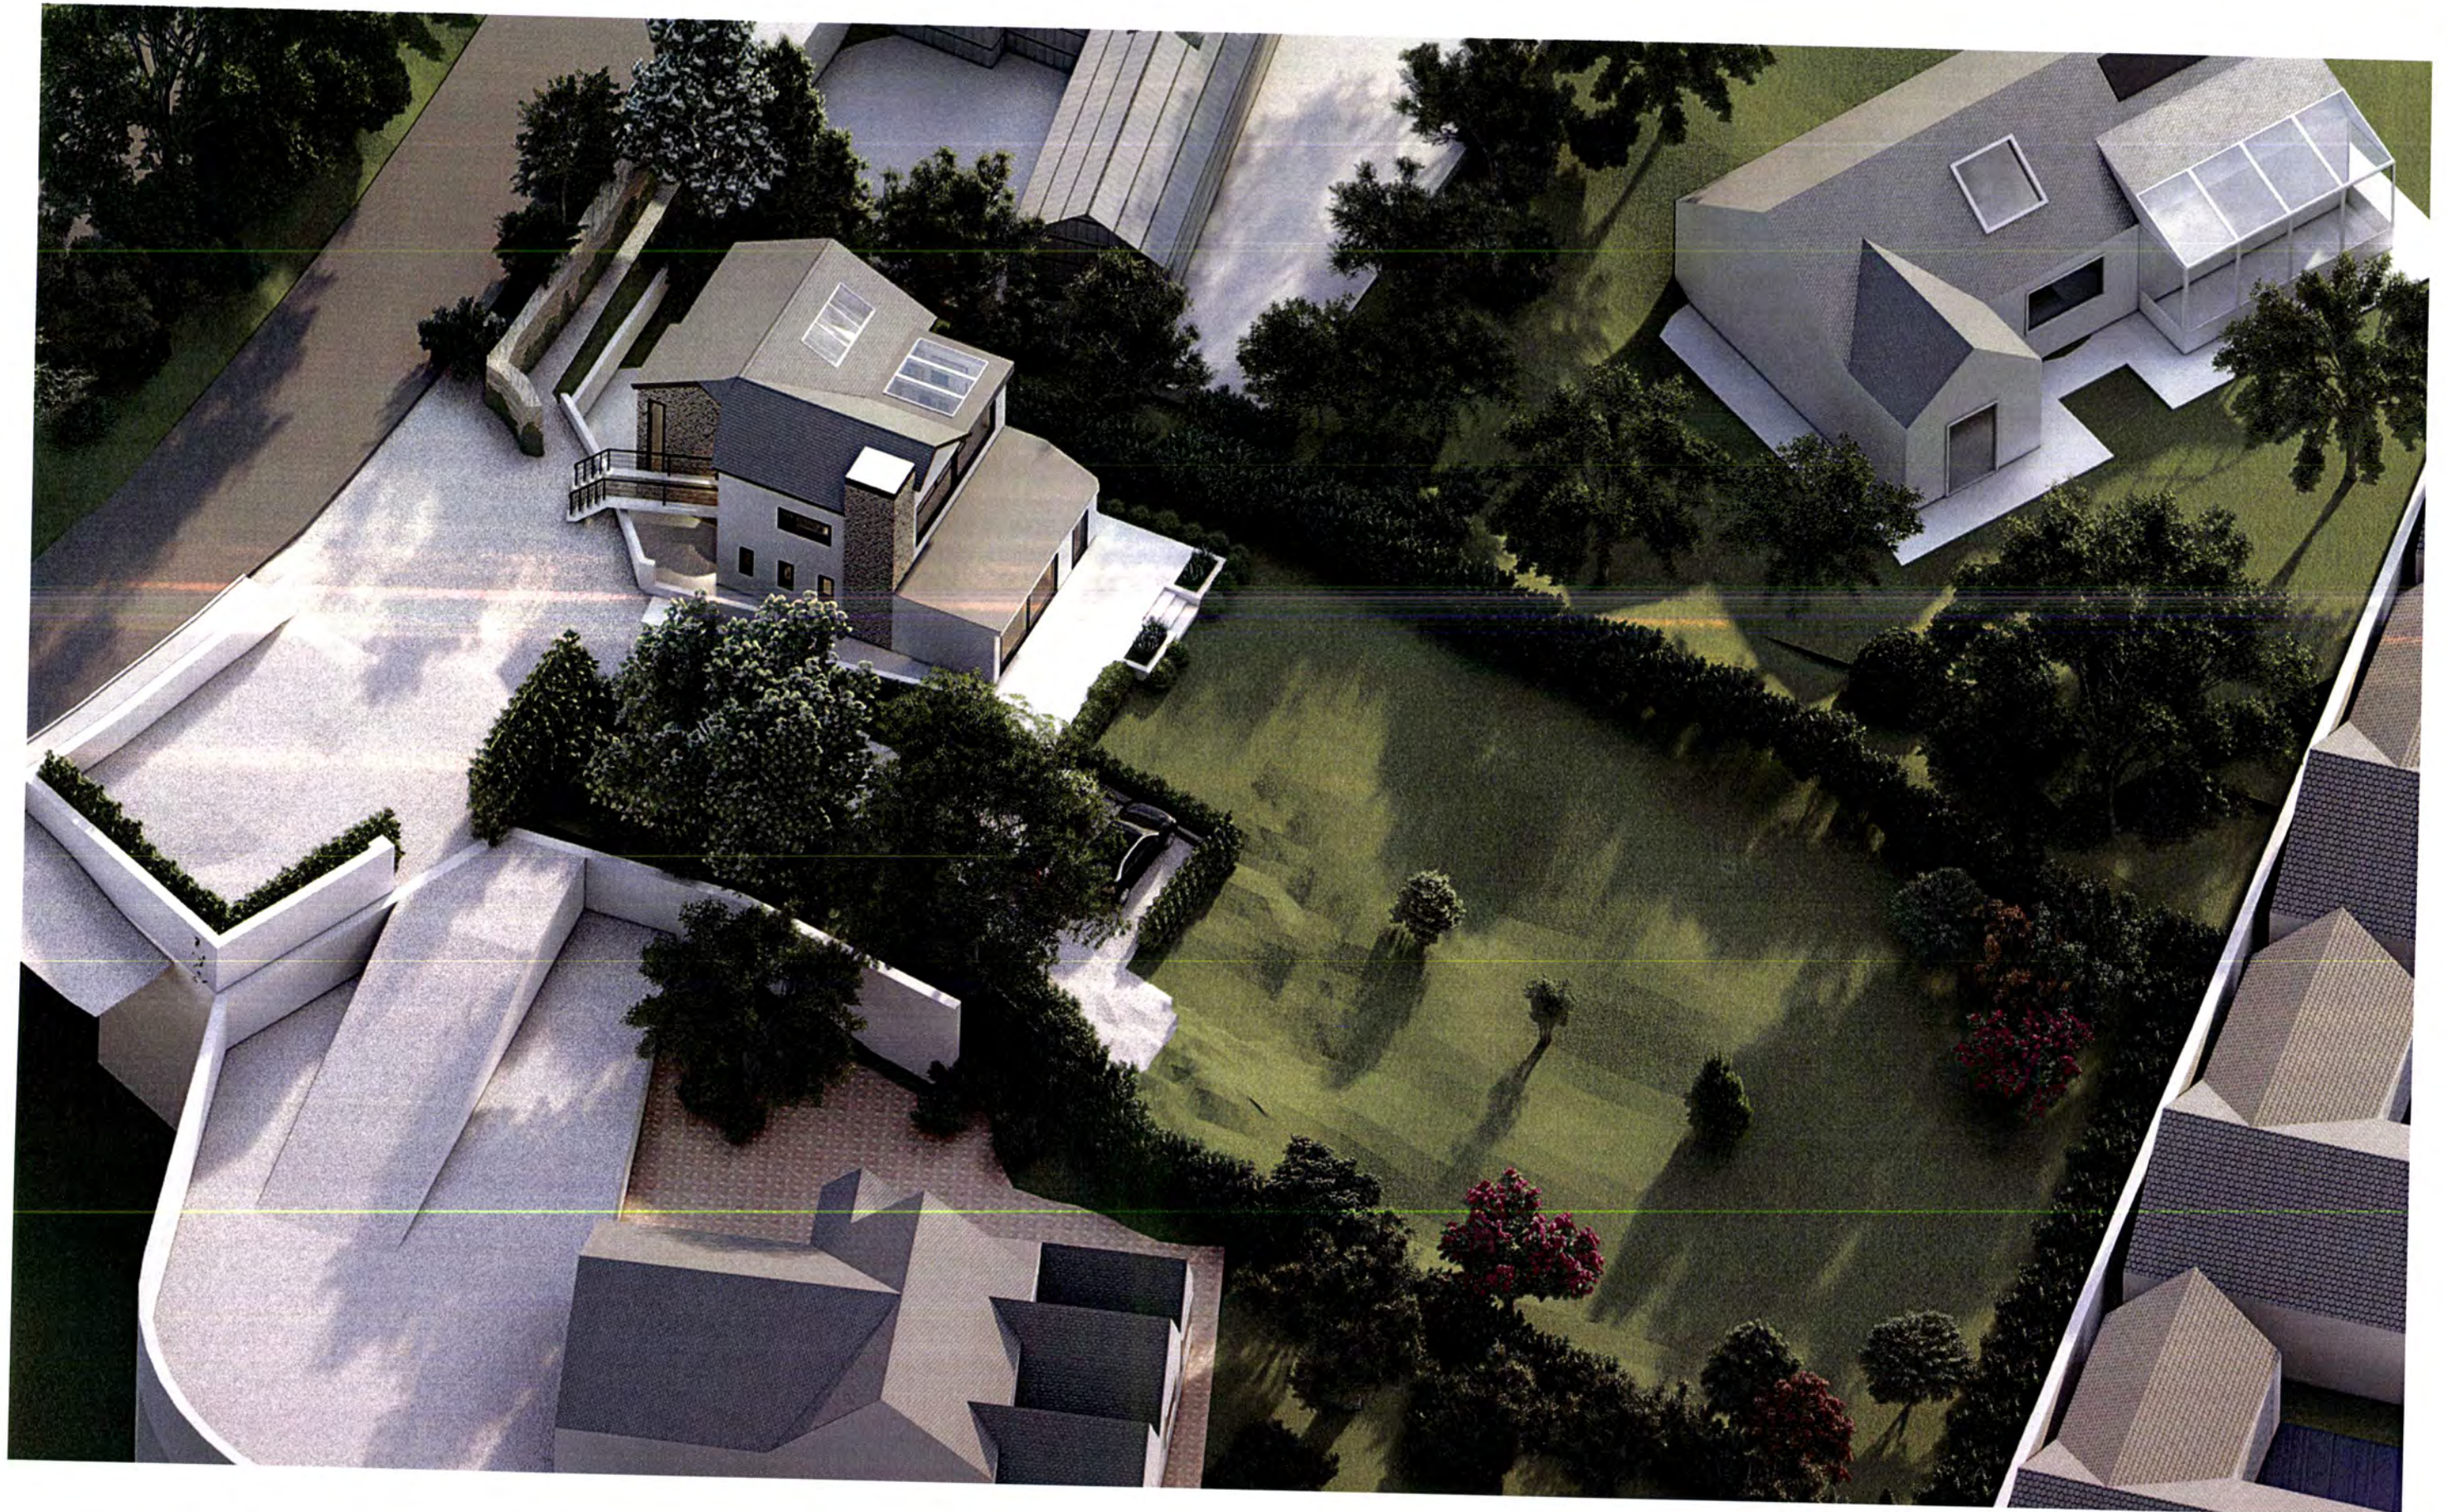



# AXONOMETRIC VIEW- new additions

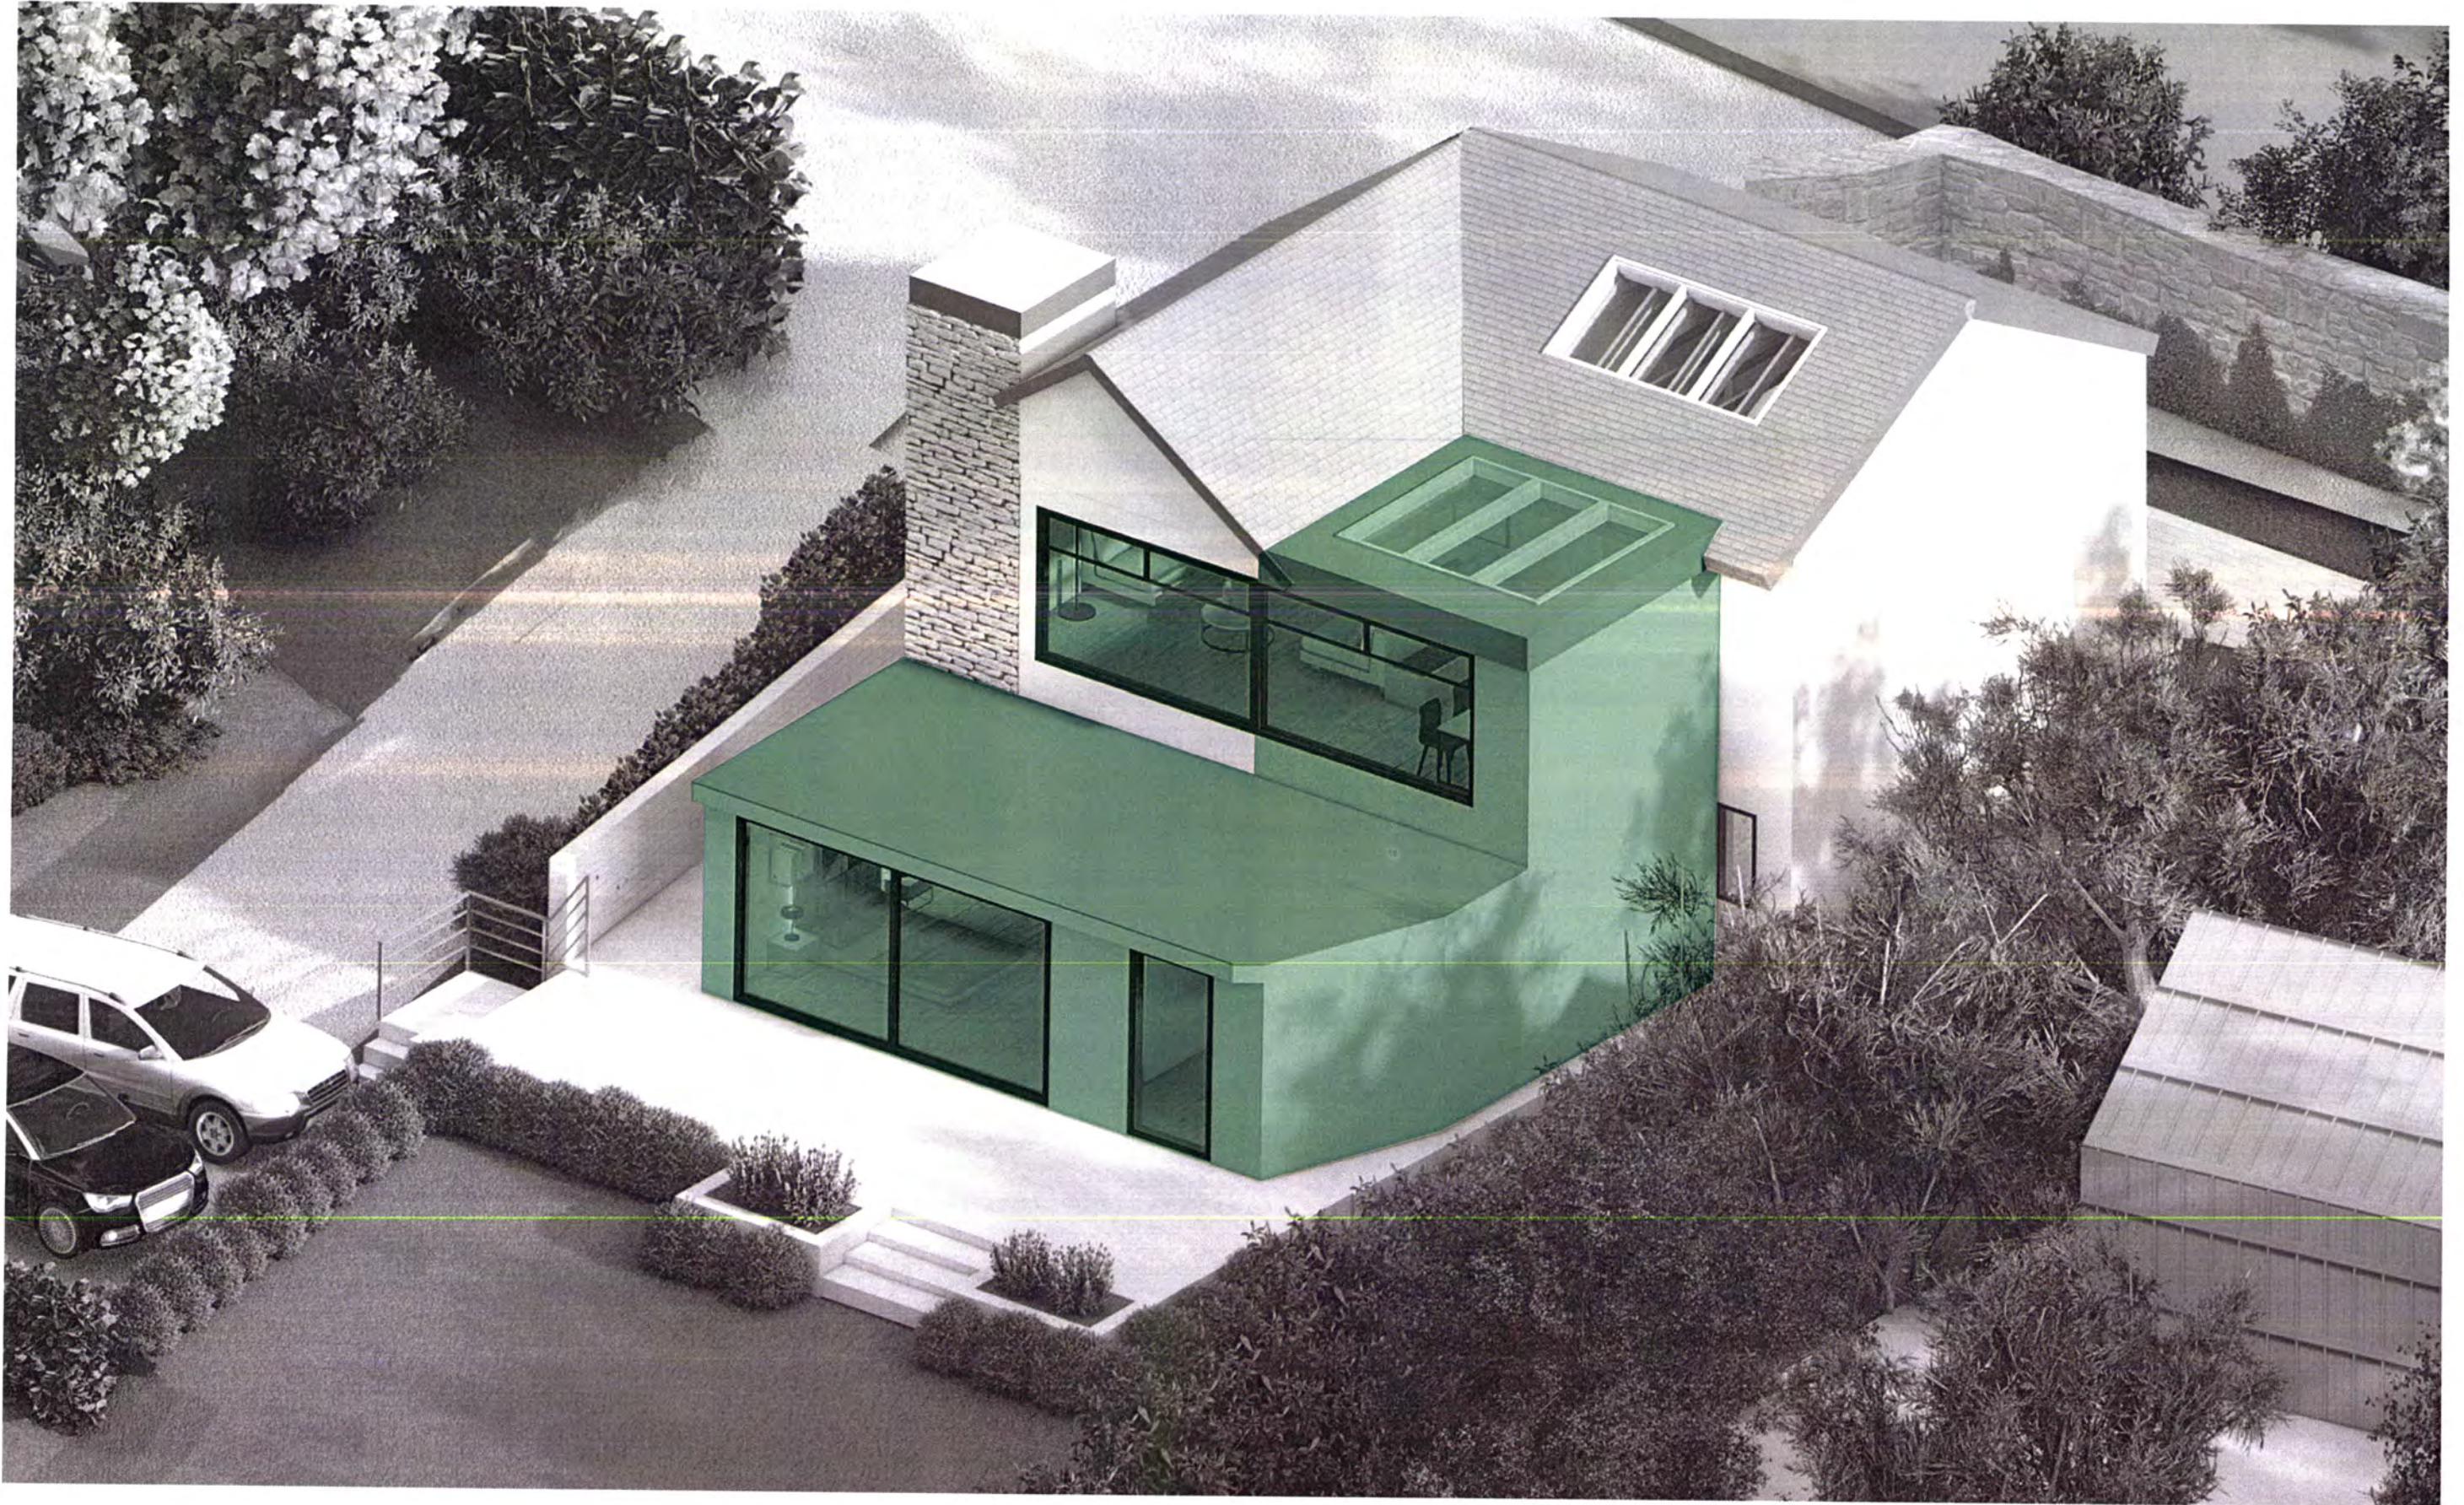



# AXONOMETRIC VIEW- close up





# MAIN ENTRANCE VISUAL 1





# MAIN ENTRANCE VISUAL 2





# EXTERNAL VISUAL 1





## EXTERNAL VISUAL 2





PROPOSED INTERNAL VISUALS



# LIVING ROOM





# KITCHEN- visual





# MASTER BEDROOM- visual 1





## BEDROOM 3- visual

